

MW3

1 LOCATION OF WATER WELL: County: RUSSELL	Fraction: NW 1/4 SW 1/4 NW 1/4	Section Number: 32	Township Number: T 13 S	Range Number: R 15 E
---	---------------------------------------	---------------------------	--------------------------------	-----------------------------

Distance and direction from nearest town or city street address of well if located within city?
99 MARKET E HWY 40, GORHAM, KS

2 WATER WELL OWNER: WEIGEL OIL CO. RR#, St. Address, Box #: PO BOX 136 City, State, ZIP Code: GORHAM KS 67640	Board of Agriculture, Division of Water Resources Application Number:
--	--

3 LOCATE WELL'S LOCATION WITH AN "X" IN SECTION BOX:

4 DEPTH OF COMPLETED WELL: **20** ft. ELEVATION: **1908.14**

Depth(s) Groundwater Encountered 1. **14.5** ft. 2. ft. 3. ft.

WELL'S STATIC WATER LEVEL: **8.20** ft. below land surface measured on mo/day/yr **04/06/98**

Pump test data: Well water was ft. after hours pumping gpm

Est. Yield gpm: Well water was ft. after hours pumping gpm


Bore Hole Diameter: **8.5** in. to **24** ft., and in. to ft.

WELL WATER TO BE USED AS:

5 Public water supply	8 Air conditioning	11 Injection well
1 Domestic	3 Feedlot	6 Oil field water supply
2 Irrigation	4 Industrial	7 Lawn and garden only
		10 <u>Monitoring well</u>

Was a chemical/bacteriological sample submitted to Department? Yes No **X** ; If yes, mo/day/yr sample was submitted

Water Well Disinfected? Yes No **X**

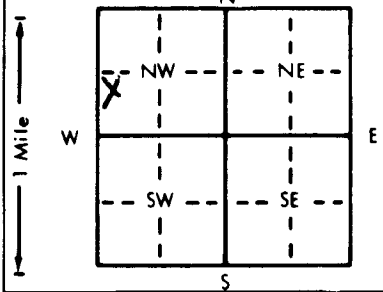

5 TYPE OF BLANK CASING USED:

1 Steel	3 RMP (SR)	5 Wrought iron	8 Concrete tile	CASING JOINTS: Glued Clamped
<u>2 PVC</u>	4 ABS	6 Asbestos-Cement	9 Other (specify below)	Welded
		7 Fiberglass		<u>Threaded</u>

Blank casing diameter: **2** in. to ft., Dia. in. to ft., Dia. in. to ft.

Casing height above land surface: **2.28** in., weight: **2.073** lbs./ft. Wall thickness or gauge No. **0.13**

TYPE OF SCREEN OR PERFORATION MATERIAL:

1 Steel	3 Stainless steel	5 Fiberglass	8 RMP (SR)	10 Asbestos-cement
2 Brass	4 Galvanized steel	6 Concrete tile	9 ABS	11 Other (specify)
				12 None used (open hole)

SCREEN OR PERFORATION OPENINGS ARE:

1 Continuous slot	<u>3 Mill slot</u>	5 Gauzed wrapped	8 Saw cut	11 None (open hole)
2 Louvered shutter	4 Key punched	6 Wire wrapped	9 Drilled holes	
		7 Torch cut	10 Other (specify)	

SCREEN-PERFORATED INTERVALS: From **10** ft. to **20** ft., From ft. to ft.

GRAVEL PACK INTERVALS: From **8** ft. to **24** ft., From ft. to ft.

6 GROUT MATERIAL: 1 Neat cement 2 Cement grout 3 Bentonite 4 Other

Grout intervals: From **1** ft. to **8** ft., From ft. to ft., From ft. to ft.

What is the nearest source of possible contamination:

1 Septic tank	4 Lateral lines	7 Pit privy	<u>11 Fuel storage</u>	14 Abandoned water well
2 Sewer lines	5 Cess pool	8 Sewage lagoon	12 Fertilizer storage	15 Oil well/Gas well
3 Watertight sewer lines	6 Seepage pit	9 Feedyard	13 Insecticide storage	16 Other (specify below)

Direction from well? **W** How many feet? **80'**

FROM	TO	LITHOLOGIC LOG	FROM	TO	PLUGGING INTERVALS
0	11	SILTY CLAY			
11	18	SILTY SANDY CLAY			
18	22	SAND			
22	24	SILTY CLAY			

7 CONTRACTOR'S OR LANDOWNER'S CERTIFICATION: This water well was constructed (2) reconstructed, or (3) plugged under my jurisdiction and was completed on (mo/day/year) **03/30/98** and this record is true to the best of my knowledge and belief. Kansas Water Well Contractor's License No. **594** This Water Well Record was completed on (mo/day/yr) **05/07/98** under the business name of **CORANCO INC.** by (signature)

INSTRUCTIONS: Use typewriter or ball point pen. PLEASE PRESS FIRMLY and PRINT clearly. Please fill in blanks, underline or circle the correct answers. Send top three copies to Kansas Department of Health and Environment, Bureau of Water, Topeka, Kansas 66620-0001. Telephone: 913-296-5545. Send one to WATER WELL OWNER and retain one for your records.