

WATER WELL PLUGGING RECORD Form WWC-5P

KSA 82a-1212

ID NO.

343141

1 LOCATION OF WATER WELL: County: Russell	Fraction NW ¼ SW ¼ SW ¼ ¼	Section Number 32	Township Number T 13 S	Range Number 15 <input type="checkbox"/> E <input checked="" type="checkbox"/> W
---	------------------------------	----------------------	---------------------------	---

Street/Rural Address of Well Location: if unknown, distance & direction from nearest town or intersection: If at owner's address, check here

Old Highway 40 & Clifford St., Gorham, KS

Global Positioning Systems (GPS) information:

Latitude: _____ (in decimal degrees)

Longitude: _____ (in decimal degrees)

Elevation: _____

Datum: WGS84, NAD83, NAD27

Collection Method:


GPS unit (Make/Model: _____)

Digital Map/Photo, Topographic Map, Land Survey

Est. Accuracy: < 3 m, 3-5 m, 5-15 m, > 15 m

2 WATER WELL OWNER: Ms. Cecil Weigel
RR#, St. Address, Box #: P.O. Box 136
City, State ZIP Code: Gorham, KS 67640

3 MARK WELL'S LOCATION WITH AN "X" IN SECTION BOX:

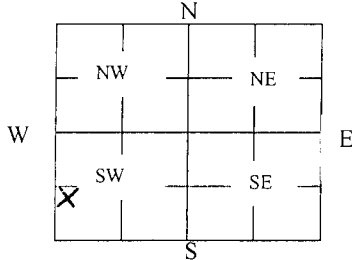

4 DEPTH OF WELL 18.5 **ft.**

WELL'S STATIC WATER LEVEL _____ ft

WELL WAS USED AS:

- Domestic
- Irrigation
- Feedlot
- Industrial

- Public Water Supply
- Oil Field Water Supply
- Domestic (Lawn & Garden)
- Air Conditioning

- Dewatering
- Monitoring
- Injection Well
- Other Soil Vapor

Was a chemical/bacteriological sample submitted to Department? Yes No

5 TYPE OF BLANK CASING USED:

- Steel
- PVC
- RMP (SR)
- ABS
- Wrought
- Asbestos-Cement
- Fiberglass
- Concrete Tile
- Other (Specify below) _____

Blank casing diameter 4 in. Was casing pulled? Yes No If yes, how much ~3ft. below ground surface
Casing height above or below land surface 36 in.

6 GROUT PLUG MATERIAL: Neat cement Cement grout Bentonite Other _____

Grout Plug Intervals: From 3 ft. to 18.5 ft., From _____ ft. to _____ ft., From _____ to _____ ft.

What is the nearest source of possible contamination:

- Septic tank
- Sewer lines
- Watertight sewer lines
- Lateral lines
- Cess pool
- Seepage pit
- Pit privy
- Sewage lagoon
- Feedyard
- Livestock pens
- Fuel Storage
- Fertilizer storage
- Insecticide storage
- Abandoned water well
- Oil well/Gas well
- Other (specify below) _____

Direction from well? _____
How many feet? _____

FROM	TO	PLUGGING MATERIALS	FROM	TO	PLUGGING MATERIALS
3	18.5	Bentonite			
					SVE-7

7 CONTRACTOR'S OR LANDOWNER'S CERTIFICATION: This water well was plugged under my jurisdiction and was completed on (mo/day/year) 6/6/2013 and this record is true to the best of my knowledge and belief. Kansas Water Well Contractor's License No. _____. This Water Well Record was completed on (mo/day/year) 6/14/2013 under the business name of GreenField Contractors, Inc. by (signature) Melisa D. Melhuse

INSTRUCTIONS: Use typewriter or ballpoint pen. Please press firmly and print clearly. Please fill in blanks, underline or circle the correct answers. Send top three copies to Kansas Department of Health and Environment, Bureau of Water, Geology Section, 1000 SW Jackson St., Ste. 420, Topeka, Kansas 66612-1367. Telephone: 785/296-5524. Send one to Water Well Owner and retain one for your records. Visit us at <http://www.kdheks.gov/waterwell/index.html>.

Check one: White Copy Blue Copy Pink Copy