USE TYPEWRITER OR BALL POINT PEN-PRESS FIRMLY, PRINT CLEARLY.

WATER WELL RECORD
KSA 82a-1201-1215

Kansas Department of Health and Environment-Division of Environment
(Water well Contractors)
Topeka, Kansas 66620

1. Location of well:	County	Fraction	Section number	Township number	Range number
	ELLIS	SW 1/4 NW 1/4 NW 1/4	29	T 13 S	R 16 E (W)

2. Distance and direction from nearest town or city: 1 N 2 W 1/2 N
Street address of well location if in city: WALKER, KS.

3. Owner of well: Killian Braun
R.R. or street: RR WALKER, KS.
City, state, zip code:

4. Locate with "X" in section below:

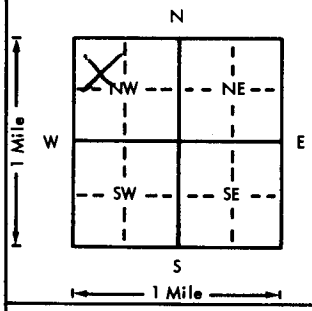

Sketch map:

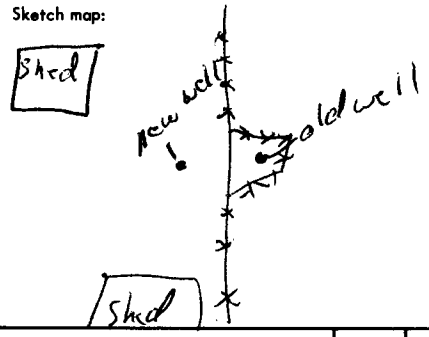

6. Bore hole dia. 9 in. Completion date 11/19/77
Well depth 40 ft.

7. __ Cable tool ✓ Rotary __ Driven __ Dug
__ Hollow rod __ Jetted __ Bored __ Reverse rotary

8. Use: __ Domestic __ Public supply __ Industry
__ Irrigation __ Air conditioning ✓ Stock
__ Lawn __ Oil field water __ Other

9. Casing: Material ____ Height: Above or below
Threaded ____ Welded 9 Surface 16 in.
RMP ____ PVC ✓ Weight ____ lbs./ft.
Dia. 5 in. to 40 ft. depth Wall Thickness: inches or
Dia. ____ in. to ____ ft. depth gage No. 160 PSI

X Screen: Manufacturer's name Jet Stream
Type PVC Dia. 5"
Slot/gauze ____ Length 10
Set between 30 ft. and 40 ft.
____ ft. and ____ ft.
Gravel pack? ✓ Size range of material 1/4-1/8

X Static water level: mo./day/yr.
30 ft. below land surface Date 11-19-77

12. Pumping level below land surfaces:
30 ft. after 1 hrs. pumping 10 g.p.m.
____ ft. after ____ hrs. pumping ____ g.p.m.
Estimated maximum yield 10 g.p.m.

13. Water sample submitted: mo./day/yr.
__ Yes ✓ No Date ____

14. Well head completion:
__ Pitless adapter 16 Inches above grade

X Well grouted? YES
With: __ Neat cement __ Bentonite ✓ Concrete
Depth: From Top ft. to 8 ft.

16. Nearest source of possible contamination: none
ft. ____ Direction ____ Type ____
Well disinfected upon completion? ✓ Yes __ No

17. Pump: ✓ Not installed
Manufacturer's name ____
Model number ____ HP ____ Volts ____
Length of drop pipe ____ ft. capacity ____ g.p.m.
Type:
__ Submersible __ Turbine
__ Jet __ Reciprocating
__ Centrifugal __ Other

5. Type and color of material	From	To
Topsoil	0	3
Subsoil - yellow	3	6
Fine to medium sand	6	37
Blue shale	37	40

(Use a second sheet if needed)

T R W Sec 1/4 1/4 1/4

18. Elevation:

Topography:
__ Hill
__ Slope
X Upland
__ Valley

19. Remarks:

20. Water well contractor's certification:
This well was drilled under my jurisdiction and this report is true to the best of my knowledge and belief.
Forst WATER WELL DRLG
Business name License No.
Address HILLSBORO 194-A
Signed [signature] Date 11-21-77
Authorized representative

Forward the white, blue and pink copies to the Department of Health and Environment

Form WWC-5

MI-1023