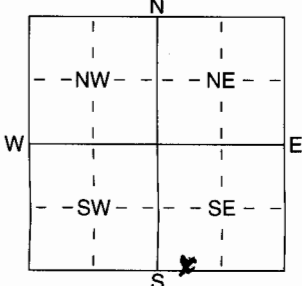


1 LOCATION OF WATER WELL: Fraction 1/4 SW 1/4 SE 1/4 Section Number 32 Township Number T 13 S Range Number R 16 E/W  
 County: Ellis

Distance and direction from nearest town or city street address of well if located within city?  
1 NORTH of Victoria 1 3/4 MILE EAST North side of Rd.

2 WATER WELL OWNER: Brad Sander  
 RR#, St. Address, Box # : 2134 Golf course Rd Board of Agriculture, Division of Water Resources  
 City, State, ZIP Code : Kagannon KS Victoria, Ks 67671 Application Number:

3 LOCATE WELL'S LOCATION WITH AN "X" IN SECTION BOX: 4 DEPTH OF COMPLETED WELL 42 ft. ELEVATION: .....  
  
 Depth(s) Groundwater Encountered 1 28 ft. 2 ..... ft. 3 ..... ft.  
 WELL'S STATIC WATER LEVEL 28 ft. below land surface measured on mo/day/yr .....  
 Pump test data: Well water was ..... ft. after ..... hours pumping ..... gpm  
 Est. Yield 5 gpm: Well water was ..... ft. after ..... hours pumping ..... gpm  
 WELL WATER TO BE USED AS: 5 Public water supply 8 Air conditioning 11 Injection well  
1 Domestic 3 Feedlot 6 Oil field water supply 9 Dewatering 12 Other (Specify below)  
2 Irrigation 4 Industrial 7 Domestic (lawn & garden) 10 Monitoring well .....  
 Was a chemical/bacteriological sample submitted to Department? Yes ..... No ; If yes, mo/day/yr sample was submitted  
 Water Well Disinfected? Yes  No

5 TYPE OF BLANK CASING USED: 1 Steel 3 RMP (SR) 5 Wrought iron 8 Concrete tile CASING JOINTS: Glued  Clamped .....  
2 PVC 4 ABS 6 Asbestos-Cement 9 Other (specify below) Welded .....  
 7 Fiberglass ..... Threaded .....  
 Blank casing diameter 5 in. to 42 ft., Dia ..... in. to ..... ft., Dia ..... in. to ..... ft.  
 Casing height above land surface 15" in., weight 160 lbs./ft. Wall thickness or gauge No. SPR 26  
 TYPE OF SCREEN OR PERFORATION MATERIAL: 1 Steel 3 Stainless Steel 5 Fiberglass 7 PVC 10 Asbestos-Cement  
 2 Brass 4 Galvanized Steel 6 Concrete tile 8 RMP (SR) 11 Other (Specify) .....  
 9 ABS 12 None used (open hole)  
 SCREEN OR PERFORATION OPENINGS ARE: 1 Continuous slot 3 Mill slot 5 Gauzed wrapped 8 Saw cut 11 None (open hole)  
 2 Louvered shutter 4 Key punched 6 Wire wrapped 9 Drilled holes  
 7 Torch cut 10 Other (specify) ..... ft.  
 SCREEN-PERFORATED INTERVALS: From 25 ft. to 42 ft., From ..... ft. to ..... ft.  
 From ..... ft. to ..... ft., From ..... ft. to ..... ft.  
 GRAVEL PACK INTERVALS: From 25 ft. to 42 ft., From ..... ft. to ..... ft.  
 From ..... ft. to ..... ft., From ..... ft. to ..... ft.

6 GROUT MATERIAL: 1 Neat cement 2 Cement grout 3 Bentonite 4 Other .....  
 Grout intervals: From 0 ft. to 23 ft., From ..... ft. to ..... ft., From ..... ft. to ..... ft.  
 What is the nearest source of possible contamination:  
 1 Septic tank 4 Lateral lines 7 Pit privy 10 Livestock pens 14 Abandoned water well  
 2 Sewer lines 5 Cess pool 8 Sewage lagoon 11 Fuel storage 15 Oil well/Gas well  
 3 Watertight sewer lines 6 Seepage pit 9 Feedyard 12 Fertilizer storage 16 Other (specify below)  
 13 Insecticide storage .....  
 Direction from well? NORTH How many feet? 150

FROM	TO	LITHOLOGIC LOG	FROM	TO	PLUGGING INTERVALS
<u>0</u>	<u>2</u>	<u>TOP SOIL</u>			
<u>2</u>	<u>23</u>	<u>CLAY</u>			
<u>23</u>	<u>27</u>	<u>CLAY &amp; SAND</u>			
<u>27</u>	<u>29</u>	<u>SAND</u>			
<u>29</u>	<u>37</u>	<u>BLUE CLAY</u>			
<u>37</u>	<u>42</u>	<u>SHALE</u>			

7 CONTRACTOR'S OR LANDOWNER'S CERTIFICATION: This water well was (1) constructed, (2) reconstructed, or (3) plugged under my jurisdiction and was completed on (mo/day/year) 4/20/05 and this record is true to the best of my knowledge and belief. Kansas Water Well Contractor's Licence No 478 This Water Well Record was completed on (mo/day/yr) 4/20/05 under the business name of PROFESSIONAL WATER WELL SERV by (signature) [Signature]