


1 LOCATION OF WATER WELL: County: Ellis Fraction: SW $\frac{1}{4}$ NE $\frac{1}{4}$ NW $\frac{1}{4}$ Section Number: 33 Township Number: T 13 (S) Range, Number: R 16 (E/W)

Distance and direction from nearest town or city street address of well if located within city?
Well # 31601 Approx 1/4 S.E. of former SEWAGE DISPOSAL plant former WALKER AAF

2 WATER WELL OWNER: U.S. Army Corps of Engineers RR#, St. Address, Box #: 700 FEDERAL Building City, State, ZIP Code: 601 EAST 12TH Street KANSAS CITY, MO 64106-2895 Board of Agriculture, Division of Water Resources Application Number: 64106-

3 LOCATE WELL'S LOCATION WITH AN "X" IN SECTION BOX:

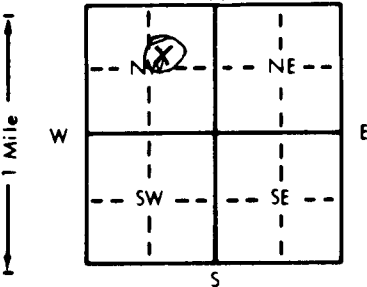

4 DEPTH OF COMPLETED WELL: 16 ft. ELEVATION: 9 ft. below land surface measured on 11/29/94
 Depth(s) Groundwater Encountered: 9 ft. 2. _____ ft. 3. _____ ft.
 WELL'S STATIC WATER LEVEL: 9 ft. below land surface measured on 11/29/94
 Pump test data: Well water was N/A ft. after _____ hours pumping _____ gpm
 Est. Yield: 2 gpm; Well water was _____ ft. after _____ hours pumping _____ gpm
 Bore Hole Diameter: 6 in. to 17 in. to _____ ft. and _____ in. to _____ ft.
 WELL WATER TO BE USED AS:
 5 Public water supply 8 Air conditioning 11 Injection well
 1 Domestic 3 Feedlot 6 Oil field water supply 9 Dewatering 12 Other (Specify below)
 2 Irrigation 4 Industrial 7 Lawn and garden only 10 Monitoring well
 Was a chemical/bacteriological sample submitted to Department? Yes _____ No X; If yes, mo/day/yr sample was submitted _____
 Water Well Disinfected? Yes _____ No X

5 TYPE OF BLANK CASING USED:
 1 Steel 3 RMP (SR) 5 Wrought iron 8 Concrete tile CASING JOINTS: Glued _____ Clamped _____
2 PVC 4 ABS 7 Fiberglass 9 Other (specify below) Welded _____
 Blank casing diameter: 2 in. to _____ ft., Dia _____ in. to _____ ft., Dia _____ in. to _____ ft.
 Casing height above land surface: 36 in., weight _____ lbs./ft. Wall thickness or gauge No. _____
 TYPE OF SCREEN OR PERFORATION MATERIAL:
 1 Steel 3 Stainless steel 5 Fiberglass 7 PVC 10 Asbestos-cement
 2 Brass 4 Galvanized steel 6 Concrete tile 9 ABS 11 Other (specify) _____
 12 None used (open hole)
 SCREEN OR PERFORATION OPENINGS ARE:
 1 Continuous slot 3 Mill slot 5 Gauzed wrapped 8 Saw cut 11 None (open hole)
 2 Louvered shutter 4 Key punched 6 Wire wrapped 9 Drilled holes
 7 Torch cut 10 Other (specify) _____

SCREEN-PERFORATED INTERVALS: From 6 ft. to 16 ft., From _____ ft. to _____ ft.
 From _____ ft. to _____ ft., From _____ ft. to _____ ft.
 GRAVEL PACK INTERVALS: From 5 ft. to 17 ft., From _____ ft. to _____ ft.
 From _____ ft. to _____ ft., From _____ ft. to _____ ft.

6 GROUT MATERIAL: 3 Neat cement 2 Cement grout 4 Bentonite 4 Other: Concrete pad w/ lock cover
 Grout Intervals: From 3 ft. to 5 ft., From 0 ft. to 3 ft., From _____ ft. to _____ ft.
 What is the nearest source of possible contamination:
 1 Septic tank 4 Lateral lines 7 Pit privy 10 Livestock pens 14 Abandoned water well
 2 Sewer lines 5 Cess pool 8 Sewage lagoon 11 Fuel storage 15 Oil well/Gas well
 3 Watertight sewer lines 6 Seepage pit 9 Feedyard 12 Fertilizer storage 16 Other (specify below): Former DoD facility
 Direction from well? North 13 Insecticide storage 1/4 mi AIR PORT.
 How many feet? 1/4 mi AIR PORT.

FROM	TO	LITHOLOGIC LOG	FROM	TO	PLUGGING INTERVALS
0	2	CLAY, SOME SILT, dry, very stiff			
2	7	Silt w/ some clay, trace sand, some caliche			
7	17	SAND, FINE TO COARSE, wet, loose, lt yellow brown			

7 CONTRACTOR'S OR LANDOWNER'S CERTIFICATION: This water well was (1) constructed, (2) reconstructed, or (3) plugged under my jurisdiction and was completed on (mo/day/year) 11/29/94 and this record is true to the best of my knowledge and belief. Kansas Water Well Contractor's License No. 555 This Water Well Record was completed on (mo/day/yr) 12/29/94 under the business name of A.W. Pool, Inc. by (signature) Keith Pool