


WATER WELL RECORD Form WWC-5 KSA 82a-1212

1 LOCATION OF WATER WELL: County: Ellipt County; Fraction: NW 1/4 NW 1/4 NE 1/4; Section Number: 33; Township Number: T 13 S; Range Number: R 16 EW

Distance and direction from nearest town or city street address of well if located within city? Well # 31503 located approx 1/2 mi south of Airfield - Walker AAF

2 WATER WELL OWNER: U.S. Army Corps of Engineers; RR#, St. Address, Box #: 700 Federal Building; City, State, ZIP Code: 601 East 12th Street Kansas City, MO. 64106-2895

3 LOCATE WELL'S LOCATION WITH AN "X" IN SECTION BOX:

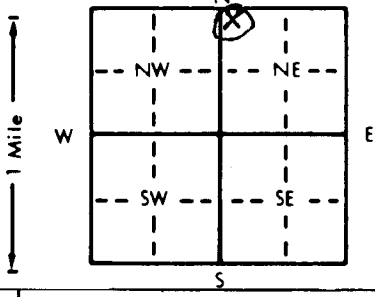

4 DEPTH OF COMPLETED WELL: 11 ft. ELEVATION:

Depth(s) Groundwater Encountered: 1. 7 ft. 2. ft. 3. ft. WELL'S STATIC WATER LEVEL: 7 ft. below land surface measured on 11/29/94. Pump test data: Well water was N/A ft. after N/A hours pumping N/A gpm. Est. Yield < 1 gpm. Well water was N/A ft. after N/A hours pumping N/A gpm. Bore Hole Diameter: 6 in. to 12 in. and ft. to ft. WELL WATER TO BE USED AS: 5 Public water supply, 8 Air conditioning, 11 Injection well, 1 Domestic, 3 Feedlot, 6 Oil field water supply, 9 Dewatering, 12 Other (Specify below), 2 Irrigation, 4 Industrial, 7 Lawn and garden only, 10 Monitoring well. Was a chemical/bacteriological sample submitted to Department? Yes No X. If yes, mo/day/yr sample was submitted Water Well Disinfected? Yes No X

5 TYPE OF BLANK CASING USED: 1 Steel, 2 PVC, 3 RMP (SR), 4 ABS, 5 Wrought iron, 6 Asbestos-Cement, 7 Fiberglass, 8 Concrete tile, 9 Other (specify below), CASING JOINTS: Glued, Clamped, Welded, Threaded X

Blank casing diameter: 2 in. to 6 in. Dia. Casing height above land surface: 36 in., weight lbs./ft. Wall thickness or gauge No. SCH 40 PVC

TYPE OF SCREEN OR PERFORATION MATERIAL: 1 Steel, 2 Brass, 3 Stainless steel, 4 Galvanized steel, 5 Fiberglass, 6 Concrete tile, 7 PVC, 8 RMP (SR), 9 ABS, 10 Asbestos-cement, 11 Other (specify), 12 None used (open hole)

SCREEN OR PERFORATION OPENINGS ARE: 1 Continuous slot, 2 Louvered shutter, 3 Mill slot, 4 Key punched, 5 Gauzed wrapped, 6 Wire wrapped, 7 Torch cut, 8 Saw cut, 9 Drilled holes, 10 Other (specify), 11 None (open hole)

SCREEN-PERFORATED INTERVALS: From 6 ft. to 11 ft. GRAVEL PACK INTERVALS: From 5 ft. to 11 ft.

6 GROUT MATERIAL: 1 Neat cement, 2 Cement grout, 3 Bentonite, 4 Other concrete prod w/ lock cover. Grout Intervals: From 3 ft. to 5 ft., From 4 ft. to 3 ft., From 4 ft. to 3 ft.

What is the nearest source of possible contamination: 1 Septic tank, 2 Sewer lines, 3 Watertight sewer lines, 4 Lateral lines, 5 Cess pool, 6 Seepage pit, 7 Pit privy, 8 Sewage lagoon, 9 Feedyard, 10 Livestock pens, 11 Fuel storage, 12 Fertilizer storage, 13 Insecticide storage, 14 Abandoned water well, 15 Oil well/Gas well, 16 Other (specify below) Former DOD Facility

Direction from well? North How many feet? 1/2 mi. Airport

Table with columns: FROM, TO, LITHOLOGIC LOG, FROM, TO, PLUGGING INTERVALS. Row 1: FROM 1 TO 4, LOG: Clay w/ silt, dry, medium Lt. yellow brown. Row 2: FROM 4 TO 8, LOG: SAND FINE TO COARSE GRAIN, trace gravel, moist, loose. Row 3: FROM 8 TO 12, LOG: Clay w/ silt, OCCASSIONAL SAND SEAMS, pale olive.

7 CONTRACTOR'S OR LANDOWNER'S CERTIFICATION: This water well was (1) constructed, (2) reconstructed, or (3) plugged under my jurisdiction and was completed on (mo/day/year) 11/29/94 and this record is true to the best of my knowledge and belief. Kansas Water Well Contractor's License No. 555 This Water Well Record was completed on (mo/day/yr) 12/21/94 under the business name of A.W. Pool, Inc. by (signature) Keith Pool

INSTRUCTIONS: Use typewriter or ball point pen. PLEASE PRESS FIRMLY and PRINT clearly. Please fill in blanks, underline or circle the correct answers. Send top three copies to Kansas Department of Health and Environment, Bureau of Water, Topeka, Kansas 66620-0001. Telephone: 913-296-5545. Send one to WATER WELL OWNER and retain one for your records.