


1 LOCATION OF WATER WELL: Fraction SE 1/4 SE 1/4 SE 1/4 Section Number 3635 Township Number T 13 S Range Number R 17 EW

Distance and direction from nearest town or city street address of well if located within city? 1.5 miles North and 1.8 miles west of Victoria Kansas

2 WATER WELL OWNER: Tim Koerner RR#, St. Address, Box #: 1207 Fern City, State, ZIP Code: Victoria, Ks. 67671 Board of Agriculture, Division of Water Resources Application Number:

3 LOCATE WELL'S LOCATION WITH AN "X" IN SECTION BOX:

4 DEPTH OF COMPLETED WELL: 40' ft. ELEVATION: N/A

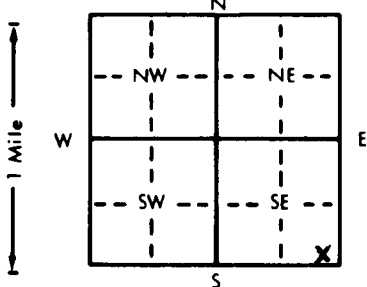

Depth(s) Groundwater Encountered 1. 24 ft. 2. ft. 3. ft. WELL'S STATIC WATER LEVEL 27 ft. below land surface measured on mo/day/yr 5-15-97 Pump test data: Well water was 31 ft. after 1 1/2 hours pumping 15 gpm Est. Yield 20+ gpm: Well water was ft. after hours pumping gpm Bore Hole Diameter 10 in. to 7.0 ft., and in. to ft. WELL WATER TO BE USED AS: 1 Domestic 3 Feedlot 6 Oil field water supply 9 Dewatering 12 Other (Specify below) 2 Irrigation 4 Industrial 7 Lawn and garden only 10 Monitoring well Was a chemical/bacteriological sample submitted to Department? Yes No; If yes, mo/day/yr sample was submitted Water Well Disinfected? Yes No

5 TYPE OF BLANK CASING USED: 1 Steel 3 RMP (SR) 5 Wrought iron 8 Concrete tile CASING JOINTS: Glued Clamped 2 PVC 4 ABS 6 Asbestos-Cement 9 Other (specify below) Welded Threaded

Blank casing diameter 5 in. to 30 ft., Dia in. to ft., Dia in. to ft. Casing height above land surface 18 in., weight lbs./ft. Wall thickness or gauge No. SDR 21

TYPE OF SCREEN OR PERFORATION MATERIAL: 1 Steel 3 Stainless steel 5 Fiberglass 8 RMP (SR) 10 Asbestos-cement 2 Brass 4 Galvanized steel 6 Concrete tile 9 ABS 12 None used (open hole)

SCREEN OR PERFORATION OPENINGS ARE: 1 Continuous slot 3 Mill slot 5 Gauzed wrapped 8 Saw cut 11 None (open hole) 2 Louvered shutter 4 Key punched 6 Wire wrapped 9 Drilled holes 7 Torch cut 10 Other (specify)

SCREEN-PERFORATED INTERVALS: From 40 ft. to 30 ft., From ft. to ft. GRAVEL PACK INTERVALS: From 40 ft. to 22 ft., From ft. to ft.

6 GROUT MATERIAL: 1 Neat cement 2 Cement grout 3 Bentonite 4 Other Grout Intervals: From 22 ft. to 0 ft., From ft. to ft.

What is the nearest source of possible contamination: 1 Septic tank 4 Lateral lines 7 Pit privy 10 Livestock pens 14 Abandoned water well 2 Sewer lines 5 Cess pool 8 Sewage lagoon 11 Fuel storage 15 Oil well/Gas well 3 Watertight sewer lines 6 Seepage pit 9 Feedyard 12 Fertilizer storage 16 Other (specify below) Site Abandoned Building

Direction from well? North west How many feet? 500'

Table with columns: FROM, TO, LITHOLOGIC LOG, FROM, TO, PLUGGING INTERVALS. Rows contain depth intervals and lithological descriptions like 'top soil', 'reddish clay', 'clay lt. brn to lb green', 'med sd w/ lms fragments', 'med to coarse sand, well rd, sub mature w/ some lms gravel', 'shale gray blue'.

7 CONTRACTOR'S OR LANDOWNER'S CERTIFICATION: This water well was (1) constructed, (2) reconstructed, or (3) plugged under my jurisdiction and was completed on (mo/day/year) 5-15-97 and this record is true to the best of my knowledge and belief. Kansas Water Well Contractor's License No. 608 This Water Well Record was completed on (mo/day/yr) 5-27-97 under the business name of Yellow Jacket Drilling by (signature) E. F. Woodell

INSTRUCTIONS: Use typewriter or ball point pen. PLEASE PRESS FIRMLY and PRINT clearly. Please fill in blanks, underline or circle the correct answers. Send top three copies to Kansas Department of Health and Environment, Bureau of Water, Topeka, Kansas 66620-0001. Telephone: 913-296-5545. Send one to WATER WELL OWNER and retain one for your records.