


1 LOCATION OF WATER WELL: County: Ellis Fraction SW 1/4 NE 1/4 NW 1/4 Section Number 4 Township Number T 13 S Range Number R 17 E/W

Distance and direction from nearest town or city street address of well if located within city?  
 4 1/4 miles east, 1/4 mile south of Hays, Kansas

2 WATER WELL OWNER: Roger Cooper  
 RR#, St. Address, Box #: 215 Victoria Road Board of Agriculture, Division of Water Resources  
 City, State, ZIP Code: Victoria, Kansas 67671 Application Number:

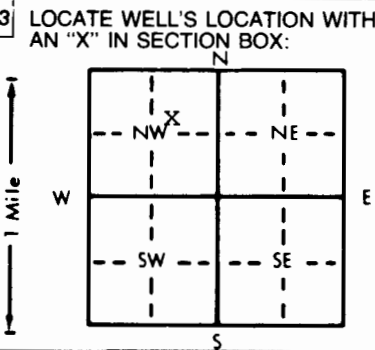

4 DEPTH OF COMPLETED WELL: 40 ft. ELEVATION: Upland  
 Depth(s) Groundwater Encountered 1. 12 ft. 2. ft. 3. ft.  
 WELL'S STATIC WATER LEVEL: 25 ft. below land surface measured on mo/day/yr 8/6/93  
 Pump test data: Well water was 25 ft. after 1 hours pumping 15 gpm  
 Est. Yield 15 gpm Well water was ft. after hours pumping gpm  
 Bore Hole Diameter 10 in. to 40 ft., and in. to ft.  
 WELL WATER TO BE USED AS: 1 Domestic 3 Feedlot 6 Oil field water supply 9 Dewatering 12 Other (Specify below)  
 2 Irrigation 4 Industrial 7 Lawn and garden only 10 Monitoring well  
 Was a chemical/bacteriological sample submitted to Department? Yes No X; If yes, mo/day/yr sample was submitted Water Well Disinfected? Yes X No

5 TYPE OF BLANK CASING USED: 2 5 Wrought iron 8 Concrete tile CASING JOINTS: Glued X Clamped  
 1 Steel 3 RMP (SR) 6 Asbestos-Cement 9 Other (specify below) Welded  
 2 PVC 4 ABS 7 Fiberglass Threaded  
 Blank casing diameter 5 in. to 20 ft., Dia in. to ft., Dia in. to ft.  
 Casing height above land surface 24 in., weight 2.29 lbs./ft. Wall thickness or gauge No. 26  
 TYPE OF SCREEN OR PERFORATION MATERIAL: 7 7 PVC 10 Asbestos-cement  
 1 Steel 3 Stainless steel 5 Fiberglass 8 RMP (SR) 11 Other (specify)  
 2 Brass 4 Galvanized steel 6 Concrete tile 9 ABS 12 None used (open hole)  
 SCREEN OR PERFORATION OPENINGS ARE: 8 5 Gauzed wrapped 8 Saw cut 11 None (open hole)  
 1 Continuous slot 3 Mill slot 6 Wire wrapped 9 Drilled holes  
 2 Louvered shutter 4 Key punched 7 Torch cut 10 Other (specify)  
 SCREEN-PERFORATED INTERVALS: From 40 ft. to 20 ft., From ft. to ft.  
 GRAVEL PACK INTERVALS: From 20 ft. to 40 ft., From ft. to ft.

6 GROUT MATERIAL: 3 1 Neat cement 2 Cement grout 3 Bentonite 4 Other  
 Grout Intervals: From 4 ft. to 24 ft., From ft. to ft., From ft. to ft.  
 What is the nearest source of possible contamination: None 10 Livestock pens 14 Abandoned water well  
 1 Septic tank 4 Lateral lines 7 Pit privy 11 Fuel storage 15 Oil well/Gas well  
 2 Sewer lines 5 Cess pool 8 Sewage lagoon 12 Fertilizer storage 16 Other (specify below)  
 3 Watertight sewer lines 6 Seepage pit 9 Feedyard 13 Insecticide storage  
 Direction from well? How many feet?

FROM	TO	LITHOLOGIC LOG	FROM	TO	PLUGGING INTERVALS
0	3	Topsoil			
3	12	Sand			
12	21	Sand and clay mix			
21	28	Sand			
28	40	Shale			

7 CONTRACTOR'S OR LANDOWNER'S CERTIFICATION: This water well was (1) constructed, (2) reconstructed, or (3) plugged under my jurisdiction and was completed on (mo/day/year) 8/6/93 and this record is true to the best of my knowledge and belief. Kansas Water Well Contractor's License No. 199 This Water Well Record was completed on (mo/day/yr) 8/18/93 under the business name of Karst Water Well Drilling & Service, Inc. by (signature)

INSTRUCTIONS: Use typewriter or ball point pen. PLEASE PRESS FIRMLY and PRINT clearly. Please fill in blanks, underline or circle the correct answers. Send top three copies to Kansas Department of Health and Environment, Bureau of Water, Topeka, Kansas 66620-0001. Telephone: 913-296-5545. Send one to WATER WELL OWNER and retain one for your records.