

1	LOCATION OF WATER WELL:	Fraction	Section Number	Township Number	Range Number
County:	<u>ELLIS</u>	<u>SE 1/4 NE 1/4 SE 1/4</u>	<u>21</u>	<u>13 S</u>	<u>17 W</u>

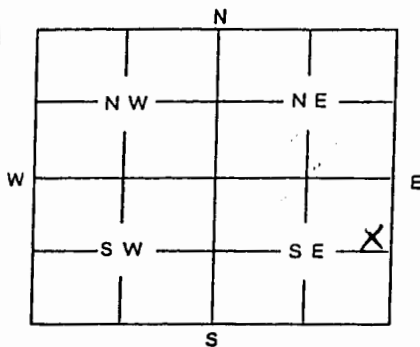
Distance and direction from nearest town or city street address of well if located within city?

1 1/2 MILES N ON TOLSON RD. FROM I-70 EXIT #163, 2 MILES W ON VINEYARD RD.2 WATER WELL OWNER: NATIONAL COOPERATIVE REFINERY ASSOCIATIONRR #, St. Address, Box #: 1391 IRONHORSE ROADCity, State, ZIP Code : MC PHERSON, KANSAS 67460

Board of Agriculture, Division of Water Resources

Application Number:

3 MARK WELL'S LOCATION WITH AN "X" IN SECTION BOX:

4 DEPTH OF WELL 20' ftWELL'S STATIC WATER LEVEL 11.3' ft.

WELL WAS USED AS:

1 Domestic

2 Irrigation

3 Feedlot

4 Industrial

5 Public Water Supply

6 Oil Field Water Supply

7 Domestic (Lawn & Garden)

8 Air Conditioning

9 Dewatering

☒ 10 Monitoring Well

11 Injection Well

12 Other

Was a chemical / bacteriological sample submitted to Department? Yes No ☒

If yes, mo/day/yr sample was submitted

Water Well Disinfected: Yes No ☒

5 TYPE OF BLANK CASING USED:

1 Steel

3 RMP (SR)

5 Wrought

7 Fiberglass

9 Other (Specify below)

☒ 2 PVC

4 ABS

6 Asbestos-Cement

8 Concrete Tile

Blank casing diameter 2 in.Was casing pulled? Yes ☒ NoIf yes, how much 20'Casing height above or below land surface 0 in.6 GROUT PLUG MATERIAL: 1 Neat cement 2 Cement grout ☒ 3 Bentonite ☒ 4 Other NATIVE SOILGrout Plug Intervals: From 1 ft. to 20 ft., From 0 ft. to 1 ft., From to ft.

What is the nearest source of possible contamination:

1 Septic tank

2 Sewer lines

3 Watertight sewer lines

4 Lateral lines

5 Cess Pool

6 Seepage pit

7 Pit privy

8 Sewage lagoon

9 Feedyard

10 Livestock pens

11 Fuel storage

12 Fertilizer storage

13 Insecticide storage

14 Abandoned water well

15 Oil well/Gas well

☒ 16 Other (specify below)UNKNOWN

Direction from well?

How many feet?

FROM	TO	PLUGGING MATERIALS
0'	1'	NATIVE SOIL
1'	12'	BENTONITE 8"
12'	20'	BENTONITE 2"

DAMAR DRILLING - MW3

7 CONTRACTOR'S OR LANDOWNER'S CERTIFICATION: This water well was plugged under my jurisdiction and was completed on (mo/day/year) 1/10/2003 and this record is true to the best of my knowledge and belief. Kansas Water Well Contractor's License No. 527 This Water Well Record was completed on (mo/day/year) 1/20/2003 under the business name of GERDALE INC. by (signature) Doe Rll

INSTRUCTIONS: Use typewriter or ball point pen. Please press firmly and print clearly. Please fill in blanks, underline or circle the correct answers. Send top three copies to Kansas Department of Health and Environment, Bureau of Water, Topeka, Kansas 66620-0001. Telephone: 785/296-3565. Send one to Water Well Owner and retain one for your records.