

|         |                         |                      |                |                 |              |
|---------|-------------------------|----------------------|----------------|-----------------|--------------|
| 1       | LOCATION OF WATER WELL: | Fraction             | Section Number | Township Number | Range Number |
| County: | ELLIS                   | SE 1/4 NE 1/4 NE 1/4 | 21             | 13 S            | 17 W         |

Distance and direction from nearest town or city street address of well if located within city?

1 1/2 MILES N ON TOLLON RD FROM I-70 EXIT #163, 2 MILES W ON VINEYARD RD.

2 WATER WELL OWNER: NATIONAL COOPERATIVE REFINERY ASSOCIATION


RR #, St. Address, Box #: 1391 IRONHORSE ROAD

City, State, ZIP Code: McPHERSON, KANSAS 67460

Board of Agriculture, Division of Water Resources

Application Number:

3 MARK WELL'S LOCATION WITH AN "X" IN SECTION BOX:

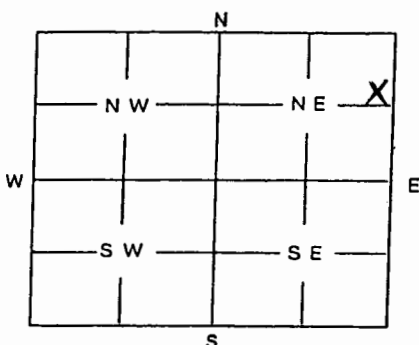

4 DEPTH OF WELL 15.6' ft

WELL'S STATIC WATER LEVEL 11.8' ft.

WELL WAS USED AS:

1 Domestic

2 Irrigation

3 Feedlot

4 Industrial

5 Public Water Supply

6 Oil Field Water Supply

7 Domestic (Lawn &amp; Garden)

8 Air Conditioning

9 Dewatering

(10) Monitoring Well

11 Injection Well

12 Other

Was a chemical / bacteriological sample submitted to Department? Yes No ☒

If yes, mo/day/yr sample was submitted

Water Well Disinfected: Yes No ☒

5 TYPE OF BLANK CASING USED:

1 Steel

3 RMP (SR)

5 Wrought

7 Fiberglass

9 Other (Specify below)

(2) PVC

4 ABS

6 Asbestos-Cement

8 Concrete Tile

Blank casing diameter 2 in.

Was casing pulled? Yes ☒ No

If yes, how much 14.8'

Casing height above or below land surface 0 in.

6 GROUT PLUG MATERIAL:

1 Neat cement

2 Cement grout

(3) Bentonite

(4) Other NATIVE SOIL

Grout Plug Intervals: From 1 ft. to 15.6 ft., From 0 ft. to 1 ft., From to ft.

What is the nearest source of possible contamination:

1 Septic tank

2 Sewer lines

3 Watertight sewer lines

4 Lateral lines

5 Cess Pool

6 Seepage pit

7 Pit privy

8 Sewage lagoon

9 Feedyard

10 Livestock pens

11 Fuel storage

12 Fertilizer storage

13 Insecticide storage

14 Abandoned water well

15 Oil well/Gas well

(16) Other (specify below)

UNKNOWN

Direction from well? \_\_\_\_\_

How many feet? \_\_\_\_\_

| FROM | TO    | PLUGGING MATERIALS |
|------|-------|--------------------|
| 0'   | 1'    | NATIVE SOIL        |
| 1'   | 12'   | BENTONITE 8"       |
| 12'  | 15.6' | BENTONITE 2"       |
|      |       |                    |
|      |       |                    |
|      |       |                    |
|      |       |                    |

DANIEL DRILLING - INC

7 CONTRACTOR'S OR LANDOWNER'S CERTIFICATION: This water well was plugged under my jurisdiction and was completed on (mo/day/year) 1/10/2003 and this record is true to the best of my knowledge and belief. Kansas Water Well Contractor's License No. 527 This Water Well Record was completed on (mo/day/year) 1/20/2003 under the business name of GEORGE INC by (signature) [Signature]

INSTRUCTIONS: Use typewriter or ball point pen. Please press firmly and print clearly. Please fill in blanks, underline or circle the correct answers. Send top three copies to Kansas Department of Health and Environment, Bureau of Water, Topeka, Kansas 66620-0001. Telephone: 785/296-3565. Send one to Water Well Owner and retain one for your records.