


1 LOCATION OF WATER WELL:	Fraction	Section Number	Township Number	Range Number
County: Ellis	NE 1/4 SE 1/4 SE 1/4	36	13	17

Distance and direction from nearest town or city street address of well if located within city?

I-70 Interchange, Victoria, Kansas

2 WATER WELL OWNER: Frank Younger	Board of Agriculture, Division of Water Resources Application Number:
RR#, St. Address, Box # P.O. Box 127	
City, State, ZIP Code : Victoria, Kansas 67671	

3 MARK WELL'S LOCATON WITH AN "X" IN SECTION BOX:

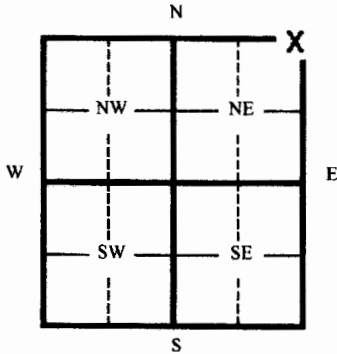

4 DEPTH OF WELL **39.0** ft.

WELL'S STATIC WATER LEVEL **30.59** ft.

WELL WAS USED AS:

- | | | |
|--------------|------------------------------|--------------------|
| 1 Domestic | 5 Public Water Supply | 9 Dewatering |
| 2 Irrigation | 6 Oil Field Water Supply | 10 Monitoring Well |
| 3 Feedlot | 7 Lawn and Garden (domestic) | 11 Injection Well |
| 4 Industrial | 8 Air Conditioning | 12 Other |

Was a chemical/bacteriological sample submitted to Department? Yes ___ No **X**

If yes, mo/day/yr sample was submitted _____

Water Well Disinfected: Yes ___ No **X**

5 TYPE OF BLANK CASING USED:

- | | | | | |
|---------|------------|-------------------|-----------------|-------------------------|
| 1 Steel | 3 RMP (SR) | 5 Wrought | 7 Fiberglass | 9 Other (specify below) |
| 2 PVC | 4 ABC | 6 Asbestos-Cement | 8 Concrete Tile | |

Blank casing diameter **2.375** in. Was casing pulled? Yes **X** No ___ If yes, how much? **14'**

Casing height above or below land surface **Unknown** in. **Removed 3' of pipe**

6 GROUT PLUG MATERIAL: 1 Neat cement 2 Cement grout 3 Bentonite 4 Other **Soils/Gravel**

Grout Plug Intervals From **39.0** ft. to **3.0** ft. From **3.0** ft. to **1.0** ft. From **1.0** ft. to **0.0** ft.

What is the nearest source of possible contamination:

- | | | | |
|--------------------------|-------------------|--------------------------|--------------------------|
| 1 Septic tank | 6 Seepage pit | 11 Fuel storage (former) | 16 Other (specify below) |
| 2 Sewer lines | 7 Pit privy | 12 Fertilizer storage | |
| 3 Watertight sewer lines | 8 Sewage lagoon | 13 Insecticide storage | |
| 4 Lateral lines | 9 Feedyard | 14 Abandoned water well | |
| 5 Cess Pool | 10 Livestock pens | 15 Oil well/ Gas well | |

Direction from well? **N/A** How many feet? **0**

FROM	TO	CODE	PLUGGING MATERIALS
0.0	1.0		Gravel
1.0	3.0		Soils
3.0	39.0		Bentonite chips

7 CONTRACTOR'S OR LANDOWNER'S CERTIFICATION: This water well was plugged under my jurisdiction and was completed on (mo/day/yr) **2/28/08** and this record is true to the best of my knowledge and belief. Kansas Water Well Contractor's License No. **692** This Water Well Record was completed on (mo/day/yr) **3/20/08** under the business name of **Quad State Services, Inc.** by (signature) *[Signature]*

INSTRUCTIONS: Please fill in blanks and circle the correct answers. Send three copies to Kansas Department of Health and Environment, Bureau of Water, 1000 S W Jackson St., Ste. 420, Topeka, Kansas 66620-0001. Telephone: 785-296-3565. Send one to Water Well Owner and retain one for your records.