


1 LOCATION OF WATER WELL: County: Ehhis Fraction: SE 1/4 SE 1/4 SE 1/4 Section Number: 34 Township Number: T 13 S Range Number: R 18 EW
 Distance and direction from nearest town or city street address of well if located within city?
1908 Marshall Rd Hays Ks

2 WATER WELL OWNER: Ron Flax
 RR#, St. Address, Box #: 1908 Marshall Board of Agriculture, Division of Water Resources
 City, State, ZIP Code: Hays Ks. 67601 Application Number:

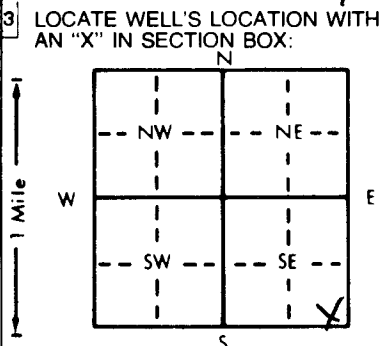

4 DEPTH OF COMPLETED WELL: 85 ft. ELEVATION: ft.
 Depth(s) Groundwater Encountered 1. 45 ft. 2. ft. 3. ft.
 WELL'S STATIC WATER LEVEL: 48 ft. below land surface measured on mo/day/yr 7/6/95
 Pump test data: Well water was 4 ft. after 1.5 hours pumping 12 gpm
 Est. Yield 12 gpm: Well water was ft. after hours pumping gpm
 Bore Hole Diameter: 1.0 in. to ft., and in. to ft.
 WELL WATER TO BE USED AS:
 5 Public water supply 8 Air conditioning 11 Injection well
 1 Domestic 3 Feedlot 6 Oil field water supply 9 Dewatering 12 Other (Specify below)
 2 Irrigation 4 Industrial 7 Lawn and garden only 10 Monitoring well
 Was a chemical/bacteriological sample submitted to Department? Yes.....No..... If yes, mo/day/yr sample was submitted
 Water Well Disinfected? Yes ✓ No

5 TYPE OF BLANK CASING USED:
 1 Steel 2 PVC 3 RMP (SR) 4 ABS
 5 Wrought iron 6 Asbestos-Cement 7 Fiberglass
 8 Concrete tile 9 Other (specify below)
 CASING JOINTS: Glued Clamped
 Welded
 Threaded
 Blank casing diameter 5 in. to ft., Dia in. to ft., Dia in. to ft.
 Casing height above land surface: 12 in., weight lbs./ft. Wall thickness or gauge No. SOR-26
 TYPE OF SCREEN OR PERFORATION MATERIAL:
 1 Steel 2 Brass 3 Stainless steel 4 Galvanized steel 5 Fiberglass 6 Concrete tile 7 PVC 8 RMP (SR) 9 ABS 10 Asbestos-cement 11 Other (specify) 12 None used (open hole)
 SCREEN OR PERFORATION OPENINGS ARE:
 1 Continuous slot 2 Louvered shutter 3 4 Mill slot 4 Key punched 5 Gauzed wrapped 6 Wire wrapped 7 Torch cut 8 Saw cut 9 Drilled holes 10 Other (specify) 11 None (open hole)
 SCREEN-PERFORATED INTERVALS: From 65 ft. to 85 ft., From ft. to ft.
 GRAVEL PACK INTERVALS: From 45 ft. to 85 ft., From ft. to ft.

6 GROUT MATERIAL: 1 Neat cement 2 2 Cement grout 3 Bentonite 4 Other
 Grout Intervals: From 4 ft. to 24 ft., From ft. to ft., From ft. to ft.
 What is the nearest source of possible contamination:
 1 Septic tank 2 Sewer lines 3 Watertight sewer lines 4 Lateral lines 5 Cess pool 6 Seepage pit 7 Pit privy 8 Sewage lagoon 9 Feedyard 10 Livestock pens 11 Fuel storage 12 Fertilizer storage 13 Insecticide storage 14 Abandoned water well 15 Oil well/Gas well 16 Other (specify below)
 Direction from well? North How many feet? 35-45

FROM	TO	LITHOLOGIC LOG	FROM	TO	PLUGGING INTERVALS
0	10	Top soil	77	83	blue clay with fine grey sand
10	45	Brown clay	83	85	shale
45	56	fine grey sand w/ layers of Brown clay			
56	66	Blue clay			
66	68	med/fine grey sand			
68	77	fine grey sand w/ layers of Brown clay			

7 CONTRACTOR'S OR LANDOWNER'S CERTIFICATION: This water well was (1) constructed, (2) reconstructed, or (3) plugged under my jurisdiction and was completed on (mo/day/year) 7/6/95 and this record is true to the best of my knowledge and belief. Kansas Water Well Contractor's License No. 276 This Water Well Record was completed on (mo/day/yr) 7/6/95 under the business name of HUSA Water Well by (signature) Jah...