


1 LOCATION OF WATER WELL: County: Ellis Fraction: NW 1/4 NW 1/4 NW 1/4 Section Number: 34 Township Number: T 13 S Range Number: R 18 E/W

Distance and direction from nearest town or city street address of well if located within city?

2610 Vine, Hays, KS

2 WATER WELL OWNER: Warren Foskett RR#, St. Address, Box #: 9425 Huhn Blvd. City, State, ZIP Code: Kansas City, Missouri 64133 Board of Agriculture, Division of Water Resources Application Number:

3 LOCATE WELL'S LOCATION WITH AN "X" IN SECTION BOX:

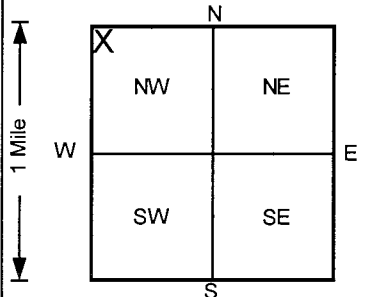

4 DEPTH OF COMPLETED WELL: 63 ft. ELEVATION: 2038.19. Depth(s) Groundwater Encountered: 1. 60 ft. 2. ft. 3. ft. WELL'S STATIC WATER LEVEL: 52.74 ft. below land surface measured on mo/day/yr 10/11/95. Pump test data: Well water was NA ft. after ... hours pumping ... gpm. Est. Yield NA gpm: Well water was ... ft. after ... hours pumping ... gpm. Bore Hole Diameter: 8 in. to 63 ft., and ... in. to ... ft. WELL WATER TO BE USED AS: 5 Public water supply 8 Air conditioning 11 Injection well 1 Domestic 3 Feedlot 6 Oil field water supply 9 Dewatering 12 Other (Specify below) 2 Irrigation 4 Industrial 7 Lawn and garden only 10 Monitoring well. Was a chemical/bacteriological sample submitted to Department? Yes... No [checked]; If yes, mo/day/yr sample was submitted. Water Well Disinfected? Yes No [checked]

5 TYPE OF BLANK CASING USED: 1 Steel 2 PVC [checked] 3 RMP (SR) 4 ABS 5 Wrought iron 6 Asbestos-Cement 7 Fiberglass 8 Concrete tile 9 Other (specify below) CASING JOINTS: Glued ... Clamped ... Welded ... Threaded [checked]. Blank casing diameter: 2 in. to 43 ft. Dia. in. to ... ft. Dia. in. to ... ft. Casing height above land surface: 4.68 in., weight ... lbs./ft. Wall thickness or gauge No. Sch. 40. TYPE OF SCREEN OR PERFORATION MATERIAL: 1 Steel 2 Brass 3 Stainless steel 4 Galvanized steel 5 Fiberglass 6 Concrete tile 7 PVC [checked] 8 RMP (SR) 9 ABS 10 Asbestos-cement 11 Other (specify) 12 None used (open hole). SCREEN OR PERFORATION OPENINGS ARE: 1 Continuous slot 2 Louvered shutter 3 Mill slot [checked] 4 Key punched 5 Gauzed wrapped 6 Wire wrapped 7 Torch cut 8 Saw cut 9 Drilled holes 10 Other (specify) 11 None (open hole). SCREEN-PERFORATED INTERVALS: From 43 ft. to 63 ft., From ... ft. to ... ft., From ... ft. to ... ft. GRAVEL PACK INTERVALS: From 40 ft. to 63 ft., From ... ft. to ... ft., From ... ft. to ... ft.

6 GROUT MATERIAL: 1 Neat cement 2 Cement grout [checked] 3 Bentonite 4 Other. Grout Intervals: From 0 ft. to 37 ft., From 37 ft. to 40 ft., From ... ft. to ... ft. What is the nearest source of possible contamination: 1 Septic tank 2 Sewer lines 3 Watertight sewer lines 4 Lateral lines 5 Cess pool 6 Seepage pit 7 Pit privy 8 Sewage lagoon 9 Feedyard 10 Livestock pens 11 Fuel storage 12 Fertilizer storage 13 Insecticide storage 14 Abandoned water well 15 Oil well/Gas well 16 Other (specify below) [checked] UST Basin. Direction from well? East How many feet? 3

Table with columns: FROM, TO, LITHOLOGIC LOG, FROM, TO, PLUGGING INTERVALS. Rows: 0-0.75 Concrete, 0.75-4 Clay, Brown, 4-8 Clay, Dark Red Brown, 8-23 Clay, Light Brown to Red Brown, 23-33 Clay, Light Gray Brown, 33-42 Clay, Red Brown, 42-63 Clay, Red Brown. Additional info: MW4, Tag # 113784, Flush; Project Name: ASB Oil Inc.; GeoCore # 61, KDHE # U6 026 676

7 CONTRACTOR'S OR LANDOWNER'S CERTIFICATION: This water well was (1) constructed, (2) reconstructed, or (3) plugged under my jurisdiction and was completed on (mo/day/year) 10/4/95 and this record is true to the best of my knowledge and belief. Kansas Water Well Contractor's License No. 527 This Water Well Record was completed on (mo/day/yr) 10/14/95 under the business name of GeoCore Services, Inc. by (signature) Dan Roll

INSTRUCTIONS: Use typewriter or ball point pen. PLEASE PRESS FIRMLY and PRINT clearly. Please fill in blanks, underline or circle the correct answers. Send top three copies to Kansas Department of Health and Environment, Bureau of Water, Topeka, Kansas 66620-0001. Telephone: 913-296-5545. Send one to WATER WELL OWNER and retain one for your records.