


Table with 5 columns: LOCATION OF WATER WELL: County: Ellis, Fraction: SW 1/4 SW 1/4 SW 1/4, Section Number: 33, Township Number: T 13 S, Range Number: R 18 E/W.

Distance and direction from nearest town or city street address of well if located within city?

335 W. 8th - Hays, Kansas

2 WATER WELL OWNER: Mr. Quik Mini Mart
RR#, St. Address, Box #: P.O. Box 1036
City, State, ZIP Code: Hays, Kansas 67601
Board of Agriculture, Division of Water Resources
Application Number:

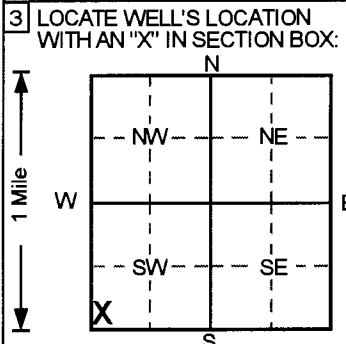

4 DEPTH OF COMPLETED WELL: 30 ft. ELEVATION: 1991.45
Depth(s) Groundwater Encountered 1: 16 ft. 2: ft. 3: ft.
WELL'S STATIC WATER LEVEL: 13.72 ft. below land surface measured on mo/day/yr 1/24/96
Pump test data: Well water was NA ft. after hours pumping gpm
Est. Yield NA gpm: Well water was ft. after hours pumping gpm
Bore Hole Diameter: 8 in. to 30 ft. and in. to ft.
WELL WATER TO BE USED AS: 5 Public water supply 8 Air conditioning 11 Injection well
1 Domestic 3 Feedlot 6 Oil field water supply 9 Dewatering 12 Other (Specify below)
2 Irrigation 4 Industrial 7 Lawn and garden only 10 Monitoring well
Was a chemical/bacteriological sample submitted to Department? Yes.....No [checked]; If yes, mo/day/yr sample was submitted
Water Well Disinfected? Yes No [checked]

5 TYPE OF BLANK CASING USED: 1 Steel 2 PVC 3 RMP (SR) 4 ABS 5 Wrought iron 6 Asbestos-Cement 7 Fiberglass 8 Concrete tile 9 Other (specify below)
Blank casing diameter: 2 in. to 10 ft. Dia in. to ft. Dia in. to ft.
Casing height above land surface: -7.56 in., weight lbs./ft. Wall thickness or gauge No. Sch. 40
CASING JOINTS: Glued Clamped Welded Threaded [checked]

TYPE OF SCREEN OR PERFORATION MATERIAL: 1 Steel 2 Brass 3 Stainless steel 4 Galvanized steel 5 Fiberglass 6 Concrete tile 7 PVC 8 RMP (SR) 9 ABS 10 Asbestos-cement 11 Other (specify) 12 None used (open hole)

SCREEN OR PERFORATION OPENINGS ARE: 1 Continuous slot 2 Louvered shutter 3 Mill slot 4 Key punched 5 Gauzed wrapped 6 Wire wrapped 7 Torch cut 8 Saw cut 9 Drilled holes 10 Other (specify) 11 None (open hole)

SCREEN-PERFORATED INTERVALS: From 10 ft. to 30 ft.
GRAVEL PACK INTERVALS: From 8 ft. to 30 ft.

6 GROUT MATERIAL: 1 Neat cement 2 Cement grout 3 Bentonite 4 Other
Grout Intervals: From 0 ft. to 6 ft., From 6 ft. to 8 ft.
What is the nearest source of possible contamination: 1 Septic tank 2 Sewer lines 3 Watertight sewer lines 4 Lateral lines 5 Cess pool 6 Seepage pit 7 Pit privy 8 Sewage lagoon 9 Feedyard 10 Livestock pens 11 Fuel storage 12 Fertilizer storage 13 Insecticide storage 14 Abandoned water well 15 Oil well/Gas well 16 Other (specify below) UST Basin

Direction from well? NW How many feet? 320

Table with columns: FROM, TO, LITHOLOGIC LOG, FROM, TO, PLUGGING INTERVALS. Rows show depth intervals (0-32) and lithology (Concrete, Clay, Sand).

7 CONTRACTOR'S OR LANDOWNER'S CERTIFICATION: This water well was (1) constructed, (2) reconstructed, or (3) plugged under my jurisdiction and was completed on (mo/day/year) 12/18/95 and this record is true to the best of my knowledge and belief.
Kansas Water Well Contractor's License No. 527 This Water Well Record was completed on (mo/day/yr) 1/18/96
under the business name of GeoCore Services, Inc. by (signature) Dale Kohl

OFFICE USE ONLY
T
R
E/W
SEC.
1/4
1/4
1/4