

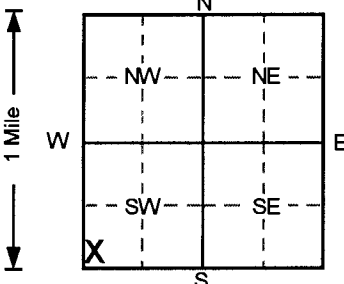
1 LOCATION OF WATER WELL: County: Ellis	Fraction SW 1/4 SW 1/4 SW 1/4	Section Number 33	Township Number T 13 S	Range Number R 18 E/W
---	---	-----------------------------	----------------------------------	---------------------------------

Distance and direction from nearest town or city street address of well if located within city?

335 W. 8th - Hays, Kansas

2 WATER WELL OWNER: **Mr. Quik Mini Mart**
 RR#, St. Address, Box # : **P.O. Box 1036**
 City, State, ZIP Code : **Hays, Kansas 67601**

Board of Agriculture, Division of Water Resources
Application Number:

<p>3 LOCATE WELL'S LOCATION WITH AN "X" IN SECTION BOX:</p>  <p>1 Mile</p>	4 DEPTH OF COMPLETED WELL: 20 ft. ELEVATION: 1991.03
	Depth(s) Groundwater Encountered 1. 15 ft. 2. _____ ft. 3. _____ ft.
	WELL'S STATIC WATER LEVEL: 13.94 ft. below land surface measured on mo/day/yr 1/24/96
	Pump test data: Well water was NA ft. after _____ hours pumping _____ gpm

Est. Yield .. **NA** gpm: Well water was _____ ft. after _____ hours pumping _____ gpm
 Bore Hole Diameter: **8** in. to **20** ft., and _____ in. to _____ ft.

WELL WATER TO BE USED AS:
 5 Public water supply 8 Air conditioning 11 Injection well
 1 Domestic 3 Feedlot 6 Oil field water supply 9 Dewatering 12 Other (Specify below)
 2 Irrigation 4 Industrial 7 Lawn and garden only 10 Monitoring well

Was a chemical/bacteriological sample submitted to Department? Yes.....No; If yes, mo/day/yr sample was submitted _____
 Water Well Disinfected? Yes _____ No

5 TYPE OF BLANK CASING USED:

1 Steel	3 RMP (SR)	5 Wrought iron	8 Concrete tile	CASING JOINTS: Glued _____ Clamped _____
2 PVC	4 ABS	6 Asbestos-Cement	9 Other (specify below) _____	Welded _____
		7 Fiberglass		Threaded <input checked="" type="checkbox"/>

Blank casing diameter: **2** in. to **10** ft., Dia _____ in. to _____ ft., Dia _____ in. to _____ ft.
 Casing height above land surface: **3** in., weight _____ lbs./ft. Wall thickness or gauge No. **Sch. 40**

TYPE OF SCREEN OR PERFORATION MATERIAL

1 Steel	3 Stainless steel	5 Fiberglass	7 PVC	10 Asbestos-cement
2 Brass	4 Galvanized steel	6 Concrete tile	8 RMP (SR)	11 Other (specify) _____
3 Mill slot			9 ABS	12 None used (open hole)

SCREEN OR PERFORATION OPENINGS ARE:

1 Continuous slot	3 Mill slot	5 Gauzed wrapped	8 Saw cut	11 None (open hole)
2 Louvered shutter	4 Key punched	6 Wire wrapped	9 Drilled holes	
		7 Torch cut	10 Other (specify) _____	

SCREEN-PERFORATED INTERVALS: From **10** ft. to **20** ft., From _____ ft. to _____ ft.
 From _____ ft. to _____ ft., From _____ ft. to _____ ft.

GRAVEL PACK INTERVALS: From **8** ft. to **20** ft., From _____ ft. to _____ ft.
 From _____ ft. to _____ ft., From _____ ft. to _____ ft.

6 GROUT MATERIAL: 1 Neat cement 2 Cement grout 3 Bentonite 4 Other _____

Grout Intervals: From **0** ft. to **6** ft., From **6** ft. to **8** ft., From _____ ft. to _____ ft.

What is the nearest source of possible contamination:

1 Septic tank	4 Lateral lines	7 Pit privy	10 Livestock pens	14 Abandoned water well
2 Sewer lines	5 Cess pool	8 Sewage lagoon	11 Fuel storage	15 Oil well/Gas well
3 Watertight sewer lines	6 Seepage pit	9 Feedyard	12 Fertilizer storage	16 Other (specify below) UST Basin

Direction from well? **W**
 How many feet? **120**

FROM	TO	LITHOLOGIC LOG	FROM	TO	PLUGGING INTERVALS
0	0.33	Asphalt,			
0.33	5.5	Clay, Medium Brown			
5.5	7	Silt, Light Yellow Brown			
7	8	Clay, Medium Brown			
8	16	Clay, Light Yellow Brown			
16	20	Sand, Light Yellow Brown			

MW13, Tag # 00113753, Flushmount
 Project Name: Mr. Quik Mini Mart #2
 GeoCore # 60, KDHE # U6 026 7548

7 CONTRACTORS OR LANDOWNER'S CERTIFICATION: This water well was **1** constructed, (2) reconstructed, or (3) plugged under my jurisdiction and was completed on (mo/day/year) **1/16/96** and this record is true to the best of my knowledge and belief.
 Kansas Water Well Contractor's License No. **527** This Water Well Record was completed on (mo/day/yr) **1/18/96**
 under the business name of **GeoCore Services, Inc.** by (signature) _____