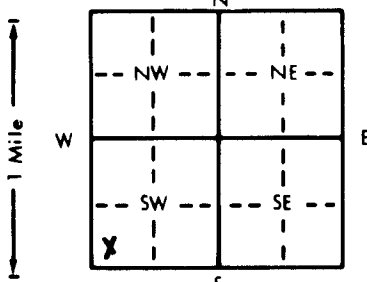


1 LOCATION OF WATER WELL: County: ELLIS	Fraction SW 1/4 SW 1/4 SW 1/4	Section Number 28	Township Number T 13 S	Range Number R 18 EW
---	---	-----------------------------	----------------------------------	--------------------------------

Distance and direction from nearest town or city street address of well if located within city?
In the City of HAYS KS

2 WATER WELL OWNER: **FIRST PRESBYTERIAN CHURCH**
 RR#, St. Address, Box #: **2900 HALL ST**
 City, State, ZIP Code: **HAYS KS 67601**
 Board of Agriculture, Division of Water Resources
 Application Number:

3 LOCATE WELL'S LOCATION WITH AN "X" IN SECTION BOX: 	4 DEPTH OF COMPLETED WELL: 70 ft. ELEVATION: Depth(s) Groundwater Encountered 1. 50 ft. 2. ft. 3. ft. WELL'S STATIC WATER LEVEL: 50 ft. below land surface measured on mo/day/yr 4-19-96 Pump test data: Well water was ft. after hours pumping gpm Est. Yield 60 gpm: Well water was ft. after hours pumping gpm Bore Hole Diameter: 10 in. to 70 ft., and in. to ft. WELL WATER TO BE USED AS: <input checked="" type="checkbox"/> Domestic 3 Feedlot 6 Oil field water supply 9 Dewatering 12 Other (Specify below) <input type="checkbox"/> Irrigation 4 Industrial 7 Lawn and garden only 10 Monitoring well Was a chemical/bacteriological sample submitted to Department? Yes No <input checked="" type="checkbox"/> ; If yes, mo/day/yr sample was submitted Water Well Disinfected? Yes No <input checked="" type="checkbox"/>
--	--

5 TYPE OF BLANK CASING USED:
 1 Steel 3 RMP (SR) 5 Wrought iron 8 Concrete tile CASING JOINTS: Glued Clamped
 PVC 4 ABS 6 Asbestos-Cement 9 Other (specify below) Welded
 7 Fiberglass Threaded
 Blank casing diameter **5** in. to **50** ft., Dia. in. to ft., Dia. in. to ft.
 Casing height above land surface **30** in., weight **160** lbs./ft. Wall thickness or gauge No.
 TYPE OF SCREEN OR PERFORATION MATERIAL: PVC 10 Asbestos-cement
 1 Steel 3 Stainless steel 5 Fiberglass 8 RMP (SR) 11 Other (specify)
 2 Brass 4 Galvanized steel 6 Concrete tile 9 ABS 12 None used (open hole)
 SCREEN OR PERFORATION OPENINGS ARE:
 1 Continuous slot Mill slot 5 Gauzed wrapped 8 Saw cut 11 None (open hole)
 2 Louvered shutter 4 Key punched 6 Wire wrapped 9 Drilled holes
 7 Torch cut 10 Other (specify)
 SCREEN-PERFORATED INTERVALS: From **50** ft. to **70** ft., From ft. to ft.
 From ft. to ft., From ft. to ft.
 GRAVEL PACK INTERVALS: From **50** **40** ft. to **70** ft., From ft. to ft.
 From ft. to ft., From ft. to ft.

6 GROUT MATERIAL: 1 Neat cement 2 Cement grout ~~3~~ Bentonite 4 Other
 Grout Intervals: From **0** ft. to **20** ft., From ft. to ft., From ft. to ft.
 What is the nearest source of possible contamination:
 1 Septic tank 4 Lateral lines 7 Pit privy 11 Fuel storage 14 Abandoned water well
 2 Sewer lines 5 Cess pool 8 Sewage lagoon 12 Fertilizer storage 15 Oil well/Gas well
 3 Watertight sewer lines 6 Seepage pit 9 Feedyard 13 Insecticide storage 16 Other (specify below)
 Direction from well? How many feet?

FROM	TO	LITHOLOGIC LOG	FROM	TO	PLUGGING INTERVALS
0	10	SURFACE CLAY			
10	42	HARD GRAY CLAY			
42	55	FINE SAND			
55	65	MED TO LARGE SAND			
65	70	SOAP STONE			

7 CONTRACTOR'S OR LANDOWNER'S CERTIFICATION: This water well was (1) constructed, (2) reconstructed, or (3) plugged under my jurisdiction and was completed on (mo/day/year) **4-19-96** and this record is true to the best of my knowledge and belief. Kansas Water Well Contractor's License No. **444** This Water Well Record was completed on (mo/day/yr) **4-19-96** under the business name of **ANDERSON DRILLING** by (signature) *Andy Anderson*

INSTRUCTIONS: Use typewriter or ball point pen. PLEASE PRESS FIRMLY and PRINT clearly. Please fill in blanks, underline or circle the correct answers. Send top three copies to Kansas Department of Health and Environment, Bureau of Water, Topeka, Kansas 66620-0001. Telephone: 913-296-5545. Send one to WATER WELL OWNER and retain one for your records.

OFFICE USE ONLY
T
R
EW
SEC.
1/4
1/4
1/4