


1 LOCATION OF WATER WELL: County: **ELLIS** Fraction: **NE 1/4 SW 1/4 SW 1/4** Section Number: **27** Township Number: **T 13 S** Range Number: **R 18 E W**

Distance and direction from nearest town or city street address of well if located within city?  
**IN THE CITY OF HAYS KS**

2 WATER WELL OWNER: **BILL BOSTELMAN**  
 RR#, St. Address, Box # : **1609 E 27th Terr** Board of Agriculture, Division of Water Resources  
 City, State, ZIP Code : **HAYS KS 67601** Application Number:

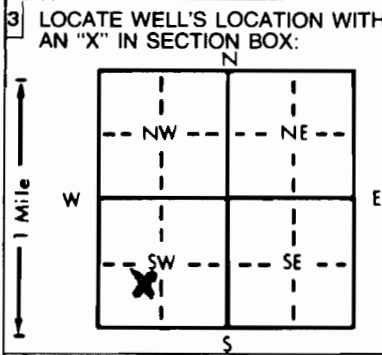

4 DEPTH OF COMPLETED WELL: **42** ft. ELEVATION:  
 Depth(s) Groundwater Encountered 1. **25** ft. 2. ft. 3. ft.  
 WELL'S STATIC WATER LEVEL: **22** ft. below land surface measured on **4-26-96**  
 Pump test data: Well water was ft. after hours pumping gpm  
 Est. Yield: **10** gpm: Well water was ft. after hours pumping gpm  
 Bore Hole Diameter: **10** in. to **42** ft., and in. to ft.  
 WELL WATER TO BE USED AS: 5 Public water supply 8 Air conditioning 11 Injection well  
 1 Domestic 3 Feedlot 6 Oil field water supply 9 Dewatering 12 Other (Specify below)  
 2 Irrigation 4 Industrial ~~XX~~ Lawn and garden only 10 Monitoring well  
 Was a chemical/bacteriological sample submitted to Department? Yes.....No **XX**.....; If yes, mo/day/yr sample was submitted Water Well Disinfected? Yes No **XX**

5 TYPE OF BLANK CASING USED:  
 1 Steel 3 RMP (SR) 5 Wrought iron 8 Concrete tile CASING JOINTS: Glued **XX** Clamped  
~~XX~~ PVC 4 ABS 6 Asbestos-Cement 9 Other (specify below) Welded  
 7 Fiberglass Threaded  
 Blank casing diameter: **5** in. to **22** ft., Dia. in. to ft., Dia. in. to ft.  
 Casing height above land surface: **30** in., weight: **160** lbs./ft. Wall thickness or gauge No.  
 TYPE OF SCREEN OR PERFORATION MATERIAL: ~~XX~~ PVC 10 Asbestos-cement  
 1 Steel 3 Stainless steel 5 Fiberglass 8 RMP (SR) 11 Other (specify)  
 2 Brass 4 Galvanized steel 6 Concrete tile 9 ABS 12 None used (open hole)  
 SCREEN OR PERFORATION OPENINGS ARE:  
 1 Continuous slot ~~XX~~ Mill slot 5 Gauzed wrapped 8 Saw cut 11 None (open hole)  
 2 Louvered shutter 4 Key punched 6 Wire wrapped 9 Drilled holes  
 7 Torch cut 10 Other (specify)  
 SCREEN-PERFORATED INTERVALS: From **22** ft. to **42** ft., From ft. to ft.  
 GRAVEL PACK INTERVALS: From **20** ft. to **42** ft., From ft. to ft.

6 GROUT MATERIAL: 1 Neat cement 2 Cement grout ~~XX~~ Bentonite 4 Other  
 Grout Intervals: From **0** ft. to **22** ft., From ft. to ft., From ft. to ft.  
 What is the nearest source of possible contamination:  
 1 Septic tank 4 Lateral lines 7 Pit privy 10 Livestock pens 14 Abandoned water well  
 2 Sewer lines 5 Cess pool 8 Sewage lagoon 11 Fuel storage 15 Oil well/Gas well  
 3 Watertight sewer lines 6 Seepage pit 9 Feedyard 12 Fertilizer storage 16 Other (specify below)  
 13 Insecticide storage  
 Direction from well? How many feet?

FROM	TO	LITHOLOGIC LOG	FROM	TO	PLUGGING INTERVALS
0	8	SURFACE CLAY			
8	22	HARD GRAY CLAY			
22	28	MED GRAVEL			
28	35	MED ROCK & GRAVEL			
35	40	SOAP STONE			
40	42	BLUE SHALE			

7 CONTRACTOR'S OR LANDOWNER'S CERTIFICATION: This water well was **(1)** constructed, (2) reconstructed, or (3) plugged under my jurisdiction and was completed on (mo/day/year) **4-26-96** and this record is true to the best of my knowledge and belief. Kansas Water Well Contractor's License No. **444** This Water Well Record was completed on (mo/day/yr) **4-26-96** under the business name of **ANDERSON DRILLING** by (signature) *Andy Anderson*

INSTRUCTIONS: Use typewriter or ball point pen. PLEASE PRESS FIRMLY and PRINT clearly. Please fill in blanks, underline or circle the correct answers. Send top three copies to Kansas Department of Health and Environment, Bureau of Water, Topeka, Kansas 66620-0001. Telephone: 913-296-5545. Send one to WATER WELL OWNER and retain one for your records.