


1 LOCATION OF WATER WELL: Fraction SE 1/4 SW 1/4 SE 1/4 Section Number 34 Township Number T 13 S Range Number R 18 E (N)
 County: Ellis

Distance and direction from nearest town or city street address of well if located within city?
Front Yard 1311 Douglas Drive, Hays Kansas

2 WATER WELL OWNER: George Wall
 RR#, St. Address, Box #: 1311 Douglas Drive Board of Agriculture, Division of Water Resources
 City, State, ZIP Code: Hays, Ks. 67601 Application Number:

3 LOCATE WELL'S LOCATION WITH AN "X" IN SECTION BOX: 4 DEPTH OF COMPLETED WELL: 43 ft. ELEVATION: N/A

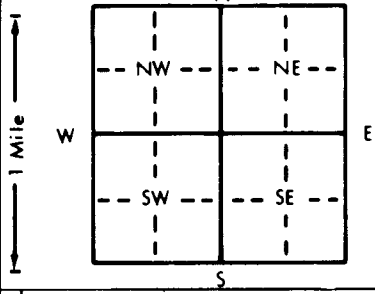

Depth(s) Groundwater Encountered 1. 33 ft. 2. ft. 3. ft.
 WELL'S STATIC WATER LEVEL 32 ft. below land surface measured on mo/day/yr 6-3-96
 Pump test data: Well water was 3.9 ft. after 1 hours pumping 3 gpm
 Est. Yield 3 gpm: Well water was ft. after hours pumping gpm
 Bore Hole Diameter 9 in. to 43 ft., and in. to ft.
 WELL WATER TO BE USED AS:
 5 Public water supply 8 Air conditioning 11 Injection well
 1 Domestic 3 Feedlot 6 Oil field water supply 9 Dewatering 12 Other (Specify below)
 2 Irrigation 4 Industrial 7 Lawn and garden only 10 Monitoring well
 Was a chemical/bacteriological sample submitted to Department? Yes No ; If yes, mo/day/yr sample was submitted
 Water Well Disinfected? Yes No

5 TYPE OF BLANK CASING USED:
 1 Steel 3 RMP (SR) 5 Wrought iron 8 Concrete tile CASING JOINTS: Glued Clamped
2 PVC 4 ABS 7 Fiberglass Splined-Certa-lok Welded
 Blanking diameter 5" in. to 33 ft., Dia. in. to ft., Dia. in. to ft.
 Casing height above land surface 18" in., weight lbs./ft. Wall thickness or gauge No. SDR 21

TYPE OF SCREEN OR PERFORATION MATERIAL:
 1 Steel 3 Stainless steel 5 Fiberglass 8 RMP (SR) 10 Asbestos-cement
 2 Brass 4 Galvanized steel 6 Concrete tile 9 ABS 11 Other (specify)
 12 None used (open hole)

SCREEN OR PERFORATION OPENINGS ARE:
 1 Continuous slot 3 Mill slot 5 Gauzed wrapped 8 Saw cut 11 None (open hole)
 2 Louvered shutter 4 Key punched 6 Wire wrapped 9 Drilled holes
 7 Torch cut 10 Other (specify)

SCREEN-PERFORATED INTERVALS: From 33 ft. to 43 ft., From ft. to ft.
 From ft. to ft., From ft. to ft.
 GRAVEL PACK INTERVALS: From 43 ft. to 25 ft., From ft. to ft.
 From ft. to ft., From ft. to ft.

6 GROUT MATERIAL: 1 Neat cement 2 Cement grout 3 Bentonite 4 Other
 Grout intervals: From 3 25 ft. to 20 ft., From 1 20 ft. to surface ft., From ft. to ft.
 What is the nearest source of possible contamination:
 1 Septic tank 4 Lateral lines 7 Pit privy 10 Livestock pens 14 Abandoned water well
 2 Sewer lines 5 Cess pool 8 Sewage lagoon 11 Fuel storage 15 Oil well/Gas well
3 Watertight sewer lines 6 Seepage pit 9 Feedyard 12 Fertilizer storage 16 Other (specify below)
 13 Insecticide storage
 Direction from well? SW How many feet? 80'

FROM	TO	LITHOLOGIC LOG	FROM	TO	PLUGGING INTERVALS
0	6	Loess			
6	13	brownish clay			
13	16	v.f. silt and sand			
16	19	s. stone w/ calcium cementation			
		v.f. grained sd.			
19	23	gray clay			
23	33	tan to brown clay with v.f. g. saturated sd. lens.			
33	35	clay and med. gr. sand 42 sand			
35	38	very mature, well rounded, well sorted unconsolidated sand			
38	40	1/8" gravel & coarse sd.			
40	43	weathered blue-gray shale			

7 CONTRACTOR'S OR LANDOWNER'S CERTIFICATION: This water well was (1) constructed, (2) reconstructed, or (3) plugged under my jurisdiction and was completed on (mo/day/year) 6-3-96 and this record is true to the best of my knowledge and belief. Kansas
 Water Well Contractor's License No. 608 This Water Well Record was completed on (mo/day/yr) 6-29-96
 under the business name of Yellow Jacket Drilling by (signature) Eric F. Waddell