


1 LOCATION OF WATER WELL: County: Ellis Fraction: NW 1/4 NW 1/4 NE 1/4 Section Number: 3 Township Number: T 13 S Range Number: R 18 EW

Distance and direction from nearest town or city street address of well if located within city?
1104 E Hwy 40 Bypass Hays Ks.

2 WATER WELL OWNER: Dean Ellner
 RR#, St. Address, Box #: 1104 E Hwy 40 Bypass Board of Agriculture, Division of Water Resources
 City, State, ZIP Code: Hays Ks. 67601 Application Number:

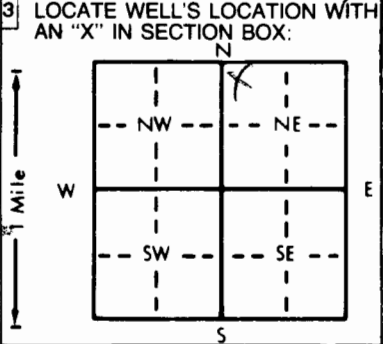

4 DEPTH OF COMPLETED WELL: 57 ft. ELEVATION: _____
 Depth(s) Groundwater Encountered 1. 37 ft. 2. _____ ft. 3. _____ ft.
 WELL'S STATIC WATER LEVEL: 37 ft. below land surface measured on mo/day/yr 7/2/96
 Pump test data: Well water was 18 ft. after 1.5 hours pumping 2.0 gpm
 Est. Yield 20 gpm: Well water was _____ ft. after _____ hours pumping _____ gpm
 Bore Hole Diameter: 12 in. to _____ ft., and _____ in. to _____ ft.
 WELL WATER TO BE USED AS:
 1 Domestic 3 Feedlot 6 Oil field water supply 9 Dewatering 12 Other (Specify below)
 2 Irrigation 4 Industrial 7 Lawn and garden only 10 Monitoring well
 Was a chemical/bacteriological sample submitted to Department? Yes _____ No _____; If yes, mo/day/yr sample was submitted _____
 Water Well Disinfected? Yes No

5 TYPE OF BLANK CASING USED:
 1 Steel 3 RMP (SR) 5 Wrought iron 8 Concrete tile CASING JOINTS: Glued Clamped
 2 PVC 4 ABS 6 Asbestos-Cement 9 Other (specify below) Welded
 _____ 7 Fiberglass _____ Threaded
 Blank casing diameter: 6 in. to _____ ft., Dia _____ in. to _____ ft., Dia _____ in. to _____ ft.
 Casing height above land surface: 18 in., weight _____ lbs./ft. Wall thickness or gauge No. S O P - 21
 TYPE OF SCREEN OR PERFORATION MATERIAL:
 1 Steel 3 Stainless steel 5 Fiberglass 7 PVC 10 Asbestos-cement
 2 Brass 4 Galvanized steel 6 Concrete tile 8 RMP (SR) 11 Other (specify) _____
 _____ _____ _____ 9 ABS 12 None used (open hole)
 SCREEN OR PERFORATION OPENINGS ARE:
 1 Continuous slot 3 Mill slot 5 Gauzed wrapped 8 Saw cut 11 None (open hole)
 2 Louvered shutter 4 Key punched 6 Wire wrapped 9 Drilled holes
 _____ _____ 7 Torch cut 10 Other (specify) _____
 SCREEN-PERFORATED INTERVALS: From 37 ft. to 57 ft., From _____ ft. to _____ ft.
 GRAVEL PACK INTERVALS: From 30 ft. to 57 ft., From _____ ft. to _____ ft.

6 GROUT MATERIAL: 1 Neat cement 2 Cement grout 3 Bentonite 4 Other _____
 Grout intervals: From 4 ft. to 24 ft., From _____ ft. to _____ ft., From _____ ft. to _____ ft.
 What is the nearest source of possible contamination:
 1 Septic tank 4 Lateral lines 7 Pit privy 10 Livestock pens 14 Abandoned water well
 2 Sewer lines 5 Cess pool 8 Sewage lagoon 11 Fuel storage 15 Oil well/Gas well
 3 Watertight sewer lines 6 Seepage pit 9 Feedyard 12 Fertilizer storage 16 Other (specify below) _____
 _____ _____ _____ 13 Insecticide storage
 Direction from well? North How many feet? 50/95

FROM	TO	LITHOLOGIC LOG	FROM	TO	PLUGGING INTERVALS
0	10	Top soil			
10	37	brown clay			
37	54	med to fine Red & grey sand m/w white gravel			
54	57	shale			

7 CONTRACTOR'S OR LANDOWNER'S CERTIFICATION: This water well was (1) constructed, (2) reconstructed, or (3) plugged under my jurisdiction and was completed on (mo/day/year) 7/2/96 and this record is true to the best of my knowledge and belief. Kansas Water Well Contractor's License No. 276 This Water Well Record was completed on (mo/day/yr) 7/2/96 under the business name of hues Water Well Drilling by (signature) John Ellner