


1 LOCATION OF WATER WELL: County: **ELLIS** Fraction **SE 1/4 SE 1/4 SE 1/4** Section Number **34** Township Number **T 13 S** Range Number **R 18 EW**

Distance and direction from nearest town or city street address of well if located within city?

**IN THE CITY OF HAYS KS**

2 WATER WELL OWNER: **ESTER WASINGER**  
 RR#, St. Address, Box #: **1310 FELTON DR** Board of Agriculture, Division of Water Resources  
 City, State, ZIP Code: **HAYS KS 67601** Application Number:

3 LOCATE WELL'S LOCATION WITH AN "X" IN SECTION BOX:

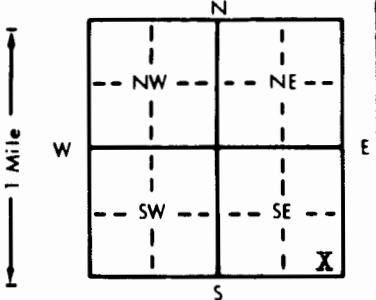

4 DEPTH OF COMPLETED WELL: **45** ft. ELEVATION: ..... ft.  
 Depth(s) Groundwater Encountered 1. **25** ft. 2. .... ft. 3. .... ft.  
 WELL'S STATIC WATER LEVEL **25** ft. below land surface measured on mo/day/yr **8-20-96**  
 Pump test data: Well water was ..... ft. after ..... hours pumping ..... gpm  
 Est. Yield **40** gpm: Well water was ..... ft. after ..... hours pumping ..... gpm  
 Bore Hole Diameter **10** in. to **45** ft., and ..... in. to ..... ft.  
 WELL WATER TO BE USED AS: 5 Public water supply 8 Air conditioning 11 Injection well  
 1 Domestic 3 Feedlot 6 Oil field water supply 9 Dewatering 12 Other (Specify below)  
 2 Irrigation 4 Industrial  Lawn and garden only 10 Monitoring well  
 Was a chemical/bacteriological sample submitted to Department? Yes.....No ; If yes, mo/day/yr sample was submitted  
 Water Well Disinfected? Yes No

5 TYPE OF BLANK CASING USED: 5 Wrought iron 8 Concrete tile CASING JOINTS: Glued  Clamped .....  
 1 Steel 3 RMP (SR) 6 Asbestos-Cement 9 Other (specify below) Welded .....  
 PVC 4 ABS 7 Fiberglass Threaded.....  
 Blank casing diameter **5** in. to **25** ft., Dia. .... in. to ..... ft., Dia. .... in. to ..... ft.  
 Casing height above land surface **18** in., weight **160** lbs./ft. Wall thickness or gauge No. ....  
 TYPE OF SCREEN OR PERFORATION MATERIAL:  PVC 10 Asbestos-cement  
 1 Steel 3 Stainless steel 5 Fiberglass 8 RMP (SR) 11 Other (specify) .....  
 2 Brass 4 Galvanized steel 6 Concrete tile 9 ABS 12 None used (open hole)  
 SCREEN OR PERFORATION OPENINGS ARE: 5 Gauzed wrapped 8 Saw cut 11 None (open hole)  
 1 Continuous slot  Mill slot 6 Wire wrapped 9 Drilled holes  
 2 Louvered shutter 4 Key punched 7 Torch cut 10 Other (specify) .....  
 SCREEN-PERFORATED INTERVALS: From **25** ft. to **45** ft., From ..... ft. to ..... ft.  
 From ..... ft. to ..... ft., From ..... ft. to ..... ft.  
 GRAVEL PACK INTERVALS: From **20** ft. to **45** ft., From ..... ft. to ..... ft.  
 From ..... ft. to ..... ft., From ..... ft. to ..... ft.

6 GROUT MATERIAL: 1 Neat cement 2 Cement grout  Bentonite 4 Other .....  
 Grout Intervals: From **0** ft. to **20** ft., From ..... ft. to ..... ft., From ..... ft. to ..... ft.  
 What is the nearest source of possible contamination:  
 1 Septic tank 4 Lateral lines 7 Pit privy 10 Livestock pens 14 Abandoned water well  
 2 Sewer lines 5 Cess pool 8 Sewage lagoon 11 Fuel storage 15 Oil well/Gas well  
 3 Watertight sewer lines 6 Seepage pit 9 Feedyard 12 Fertilizer storage 16 Other (specify below)  
 13 Insecticide storage

Direction from well?

How many feet?

FROM	TO	LITHOLOGIC LOG	FROM	TO	PLUGGING INTERVALS
0	10	<b>SURFACE CLAY</b>			
10	25	<b>HARD YELLOW CLAY</b>			
25	35	<b>MED SAND</b>			
35	42	<b>LARGE SAND</b>			
42	45	<b>BLUE SHALE</b>			

7 CONTRACTOR'S OR LANDOWNER'S CERTIFICATION: This water well was **1** constructed, (2) reconstructed, or (3) plugged under my jurisdiction and was completed on (mo/day/year) **8-20-96** and this record is true to the best of my knowledge and belief. Kansas Water Well Contractor's License No. **444** This Water Well Record was completed on (mo/day/yr) **8-20-86** under the business name of **ANDERSON DRILLING** by (signature) *Cindy Anderson*