


1 LOCATION OF WATER WELL: Fraction **SE 1/4 SW 1/4 SW 1/4** Section Number **21** Township Number **T 13 S** Range Number **R 18 E 1**
 County: **ELLIS**

Distance and direction from nearest town or city street address of well if located within city?
IN THE CITY OF HAYS KS

2 WATER WELL OWNER: **JUDY MCCOY**
 RR#, St. Address, Box #: **4103 SMOKY HILL RD ST**
 City, State, ZIP Code: **HAYS KS 67601**
 Board of Agriculture, Division of Water Resources
 Application Number:

3 LOCATE WELL'S LOCATION WITH AN "X" IN SECTION BOX:

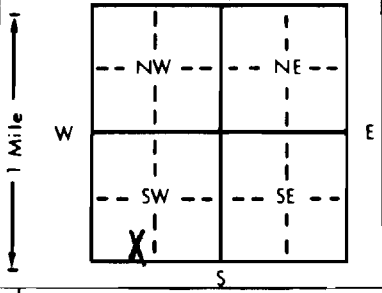

4 DEPTH OF COMPLETED WELL: **75** ft. ELEVATION:
 Depth(s) Groundwater Encountered 1. **55** ft. 2. ft. 3. ft.
 WELL'S STATIC WATER LEVEL: **55** ft. below land surface measured on mo/day/yr **9-27-96**
 Pump test data: Well water was ft. after hours pumping gpm
 Est. Yield **40** gpm: Well water was ft. after hours pumping gpm
 Bore Hole Diameter: **10** in. to **75** ft., and in. to ft.
 WELL WATER TO BE USED AS:
 5 Public water supply 8 Air conditioning 11 Injection well
 1 Domestic 3 Feedlot 6 Oil field water supply 9 Dewatering 12 Other (Specify below)
 2 Irrigation 4 Industrial **xx** Lawn and garden only 10 Monitoring well
 Was a chemical/bacteriological sample submitted to Department? Yes No **xx**; If yes, mo/day/yr sample was submitted
 Water Well Disinfected? Yes No **xx**

5 TYPE OF BLANK CASING USED:
 1 Steel **xx** PVC 3 RMP (SR) 4 ABS 5 Wrought iron 6 Asbestos-Cement 7 Fiberglass 8 Concrete tile 9 Other (specify below) CASING JOINTS: Glued **xx** Clamped Welded Threaded
 Blank casing diameter: **5** in. to **55** ft., Dia. in. to ft., Dia. in. to ft.
 Casing height above land surface: **18** in., weight **160** lbs./ft. Wall thickness or gauge No.
 TYPE OF SCREEN OR PERFORATION MATERIAL:
 1 Steel 3 Stainless steel 5 Fiberglass 8 RMP (SR) 10 Asbestos-cement 11 Other (specify)
 2 Brass 4 Galvanized steel 6 Concrete tile 9 ABS 12 None used (open hole)
 SCREEN OR PERFORATION OPENINGS ARE:
 1 Continuous slot **xx** Mill slot 5 Gauzed wrapped 8 Saw cut 11 None (open hole)
 2 Louvered shutter 4 Key punched 6 Wire wrapped 9 Drilled holes
 7 Torch cut 10 Other (specify)
 SCREEN-PERFORATED INTERVALS: From **55** ft. to **75** ft., From ft. to ft.
 GRAVEL PACK INTERVALS: From **40** ft. to **75** ft., From ft. to ft.

6 GROUT MATERIAL: 1 Neat cement 2 Cement grout **xx** Bentonite 4 Other
 Grout Intervals: From **0** ft. to **30** ft., From ft. to ft., From ft. to ft.
 What is the nearest source of possible contamination:
 1 Septic tank 4 Lateral lines 7 Pit privy 11 Fuel storage 14 Abandoned water well
 2 Sewer lines 5 Cess pool 8 Sewage lagoon 12 Fertilizer storage 15 Oil well/Gas well
 3 Watertight sewer lines 6 Seepage pit 9 Feedyard 13 Insecticide storage 16 Other (specify below)
 Direction from well? How many feet?

FROM	TO	LITHOLOGIC LOG	FROM	TO	PLUGGING INTERVALS
0	8	SURFACE CLAY			
8	25	HARD YELLOW CLAY			
25	32	SOFT GRAY CLAY			
32	50	MED YELLOW CLAY			
50	55	FINE SAND			
55	66	MED SAND			
66	68	HARD LIMESTONE			
68	74	LARGE SAND			
74	75	BLUE SHALE			

7 CONTRACTOR'S OR LANDOWNER'S CERTIFICATION: This water well was (1) constructed, (2) reconstructed, or (3) plugged under my jurisdiction and was completed on (mo/day/year) **9-27-96** and this record is true to the best of my knowledge and belief. Kansas Water Well Contractor's License No. **444** This Water Well Record was completed on (mo/day/yr) **9-27-96** under the business name of **ANDERSON DRILLING** by (signature) *Andy Anderson*

INSTRUCTIONS: Use typewriter or ball point pen. PLEASE PRESS FIRMLY and PRINT clearly. Please fill in blanks, underline or circle the correct answers. Send top three copies to Kansas Department of Health and Environment, Bureau of Water, Topeka, Kansas 66620-0001. Telephone: 913-296-5545. Send one to WATER WELL OWNER and retain one for your records.