

1 LOCATION OF WATER WELL: Fraction SE 1/4 SE 1/4 SE 1/4 Section Number SE corner 21 Township Number 13 South Range Number 18 West
 County: Ellis


Distance and direction from nearest town or city street address of well if located within city?

4101 Vine St Hays, KS

2 WATER WELL OWNER: JS Ventures

RR#, St. Address, Box #: 2400 N. Woodlawn #140 Board of Agriculture, Division of Water Resources
 City, State, ZIP Code: Wichita, KS 67220 Application Number:

3 MARK WELL'S LOCATION WITH AN "X" IN SECTION BOX:
 N

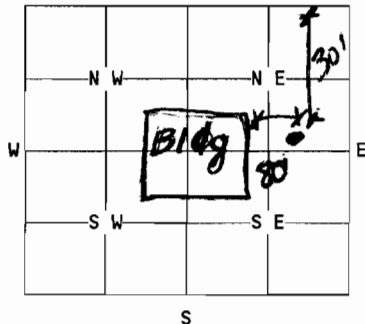

4 DEPTH OF WELL.....16'.....ft.

WELL'S STATIC WATER LEVEL.....0.....ft.

WELL WAS USED AS:

- 1 Domestic
- 2 Irrigation
- 3 Feedlot
- 4 Industrial
- 5 Public Water Supply
- 6 Oil Field Water Supply
- 7 Lawn and Garden Only
- 8 Air Conditioning
- 9 Dewatering
- 10 Monitoring Well THANK H&E
- 11 Injection Well
- 12 Other.....

Was a chemical/bacteriological sample submitted to Department? Yes... No.....
 If yes, mo/day/yr sample was submitted.....

Water Well Disinfected: Yes..... No.....

5 TYPE OF BLANK CASING USED:

- 1 Steel
- 2 PVC
- 3 RMP (SR)
- 4 ABS
- 5 Wrought
- 6 Asbestos-Cement
- 7 Fiberglass
- 8 Concrete Tile
- 9 Other (specify below)

Blank casing diameter.....4 in. Was casing pulled? Yes..... No..... If yes, how much.....
 Casing height above or below land surface.....12.....in.

6 GROUT PLUG MATERIAL: 1 Neat cement 2 Cement grout 3 Bentonite 4 Other 3500# concrete

Grout Plug Intervals: From 0..ft. to -16..ft., From.....ft. toft., From..... to.....ft.

What is the nearest source of possible contamination:

- 1 Septic tank
- 2 Sewer lines
- 3 Watertight sewer lines
- 4 Lateral lines
- 5 Cess Pool
- 6 Seepage pit
- 7 Pit privy
- 8 Sewage lagoon
- 9 Feedyard
- 10 Livestock pens
- 11 Fuel storage
- 12 Fertilizer storage
- 13 Insecticide storage
- 14 Abandoned water well
- 15 Oil well/Gas well
- 16 Other (specify below)

Direction from well? How many feet?

FROM	TO	PLUGGING MATERIALS
<u>0</u>	<u>-16'</u>	<u>3500^{PSI} Concrete</u>
<u>0</u>	<u>+8"</u>	<u>Asphalt Parking</u>

7 CONTRACTOR'S OR LANDOWNER'S CERTIFICATION: This water well was plugged under my jurisdiction and was completed on (mo/day/year)..... and this record is true to the best of my knowledge and belief. Kansas Water Well Contractor's License No. This Water Well Record was completed on (mo/day/year) under the business name of Key Construction by (signature) C. J. [Signature]

INSTRUCTIONS: Use typewriter or ball point pen. Please press firmly and print clearly. Please fill in blanks, underline or circle the correct answers. Send top three copies to Kansas Department of Health and Environment, Bureau of Water, Topeka, Kansas 66620-0001. Telephone: 913/296-3565. Send one to Water Well Owner and retain one for your records.