


WATER WELL RECORD Form WWC-5 KSA 82a-1212

1 LOCATION OF WATER WELL: County: Ellis Fraction: NE 1/4 SE 1/4 SE 1/4 Section Number: 33 Township Number: T 13 S Range Number: R 18 **EW**

Distance and direction from nearest town or city street address of well if located within city?
17th + Vine, Hays KS

2 WATER WELL OWNER: Ceroy's Diamond Shamrock VE7
 RR#, St. Address, Box #: P.O. Box 37
 City, State, ZIP Code: Hays, KS 67601
 Board of Agriculture, Division of Water Resources
 Application Number:

3 LOCATE WELL'S LOCATION WITH AN "X" IN SECTION BOX:

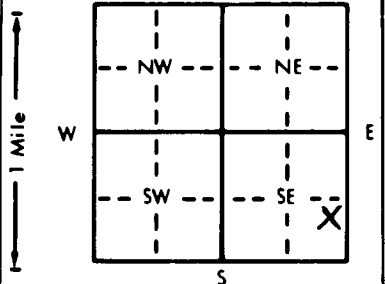

4 DEPTH OF COMPLETED WELL: 29.5 ft. ELEVATION: 2002.51
 Depth(s) Groundwater Encountered: 1. Dry well ft. 2. . ft. 3. . ft.
 WELL'S STATIC WATER LEVEL: . ft. below land surface measured on mo/day/yr
 Pump test data: Well water was . ft. after . hours pumping . gpm
 Est. Yield . gpm Well water was . ft. after . hours pumping . gpm
 Bore Hole Diameter: 8 in. to 29.5 ft., and . in. to . ft.
 WELL WATER TO BE USED AS:
 5 Public water supply 8 Air conditioning 11 Injection well
 1 Domestic 3 Feedlot 6 Oil field water supply 9 Dewatering 12 Other (Specify below)
 2 Irrigation 4 Industrial 7 Lawn and garden only 10 Monitoring well Vapor Extraction
 Was a chemical/bacteriological sample submitted to Department? Yes No; If yes, mo/day/yr sample was submitted
 Water Well Disinfected? Yes No

5 TYPE OF CASING USED:
 1 Steel 3 RMP (SR) 5 Wrought iron 8 Concrete tile CASING JOINTS: Glued . Clamped .
2 PVC 4 ABS 6 Asbestos-Cement 9 Other (specify below) Welded .
 7 Fiberglass Threaded: X

Blank casing diameter: 2 in. to 9.5 ft. Dia . in. to . ft. Dia . in. to . ft.
 Casing height above land surface: -3.24 in., weight . lbs./ft. Wall thickness or gauge No. .

TYPE OF SCREEN OR PERFORATION MATERIAL:
 1 Steel 3 Stainless steel 5 Fiberglass 8 RMP (SR) 10 Asbestos-cement
 2 Brass 4 Galvanized steel 6 Concrete tile 9 ABS 11 Other (specify) .
 12 None used (open hole)

SCREEN OR PERFORATION OPENINGS ARE:
1 Continuous slot 3 Mill slot 5 Gauzed wrapped 8 Saw cut 11 None (open hole)
 2 Louvered shutter 4 Key punched 6 Wire wrapped 9 Drilled holes
 7 Torch cut 10 Other (specify) .

SCREEN-PERFORATED INTERVALS: From 9.5 ft. to 29.5 ft., From . ft. to . ft.
 From . ft. to . ft., From . ft. to . ft.
 GRAVEL PACK INTERVALS: From 9.5 ft. to 29.5 ft., From . ft. to . ft.
 From . ft. to . ft., From . ft. to . ft.

6 GROUT MATERIAL: 1 Neat cement 2 Cement grout 3 Bentonite 4 Other .
 Grout intervals: From 0 ft. to 9.5 ft., From . ft. to . ft., From . ft. to . ft.

What is the nearest source of possible contamination:
 1 Septic tank 4 Lateral lines 7 Pit privy 11 Fuel storage 14 Abandoned water well
 2 Sewer lines 5 Cess pool 8 Sewage lagoon 12 Fertilizer storage 15 Oil well/Gas well
 3 Watertight sewer lines 6 Seepage pit 9 Feedyard 13 Insecticide storage 16 Other (specify below) .

Direction from well? How many feet?

FROM	TO	LITHOLOGIC LOG	FROM	TO	PLUGGING INTERVALS
0	9	Silty Clay to clayey silt			
9	15	Silt with siltstone stringer at 9.5			
15	15.25	Sand stringer			
15.25	20	Clayey Silt			
20	25	Clayey Silt + Silt			
25	29.5	Silty Clay grading to clayey silt			

7 CONTRACTOR'S OR LANDOWNER'S CERTIFICATION: This water well was (1) constructed, (2) reconstructed, or (3) plugged under my jurisdiction and was completed on (mo/day/year) 6-15-95 and this record is true to the best of my knowledge and belief. Kansas Water Well Contractor's License No. 534 This Water Well Record was completed on (mo/day/yr) 7-23-96 under the business name of PSI by (signature) Renton Cleve