


1 LOCATION OF WATER WELL: Fraction NE 1/4 SE 1/4 NE 1/4 Section Number 28 Township Number T 13 S Range Number R 18 E  
 County: Ellis

Distance and direction from nearest town or city street address of well if located within city?  
37th & North Vine Street, Hays, KS. 67601

2 WATER WELL OWNER: Amoco Oil Co.  
 RR#, St. Address, Box #: 37th & Vine Board of Agriculture, Division of Water Resources  
 City, State, ZIP Code: Hays, KS. 67601 Application Number:

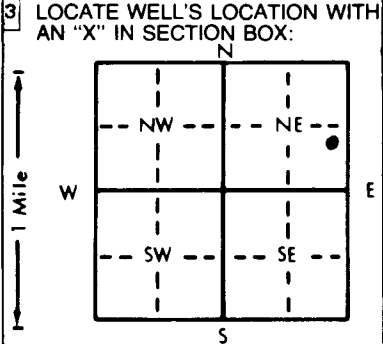

4 DEPTH OF COMPLETED WELL: 28' ft. ELEVATION: ..... ft.  
 Depth(s) Groundwater Encountered 1. 18 1/2' ft. 2. .... ft. 3. .... ft.  
 WELL'S STATIC WATER LEVEL 16.89' ft. below land surface measured on mo/day/yr 9-5-96  
 Pump test data: Well water was ..... ft. after ..... hours pumping ..... gpm  
 Est. Yield ..... gpm; Well water was ..... ft. after ..... hours pumping ..... gpm  
 Bore Hole Diameter: 8 1/2" in. to 28" in. to ..... in. to ..... in. to ..... ft.  
 WELL WATER TO BE USED AS: 5 Public water supply 8 Air conditioning 11 Injection well  
 1 Domestic 3 Feedlot 6 Oil field water supply 9 Dewatering 12 Other (Specify below)  
 2 Irrigation 4 Industrial 7 Lawn and garden only 10 Monitoring well .....  
 Was a chemical/bacteriological sample submitted to Department? Yes.....No X.....; If yes, mo/day/yr sample was submitted  
 Water Well Disinfected? Yes ..... No X.....

5 TYPE OF BLANK CASING USED: 5 Wrought iron 8 Concrete tile CASING JOINTS: Glued ..... Clamped .....  
 1 Steel 3 RMP (SR) 6 Asbestos-Cement 9 Other (specify below) Welded .....  
2 PVC 4 ABS 7 Fiberglass ..... Threaded... X .....  
 Blank casing diameter 2.375 in. to 13' ft., Dia ..... in. to ..... ft., Dia ..... in. to SDR. 13 ..... ft.  
 Casing height above land surface Flush Mt. in., weight ..... lbs./ft. Wall thickness or gauge No. SCH. 40 .....  
 TYPE OF SCREEN OR PERFORATION MATERIAL: 7 PVC 10 Asbestos-cement  
 1 Steel 3 Stainless steel 5 Fiberglass 8 RMP (SR) 11 Other (specify) .....  
 2 Brass 4 Galvanized steel 6 Concrete tile 9 ABS 12 None used (open hole)  
 SCREEN OR PERFORATION OPENINGS ARE: 5 Gauzed wrapped 8 Saw cut 11 None (open hole)  
 1 Continuous slot 3 Mill slot 6 Wire wrapped 9 Drilled holes  
 2 Louvered shutter 4 Key punched 7 Torch cut 10 Other (specify) .....  
 SCREEN-PERFORATED INTERVALS: From 28' ft. to 13' ft., From ..... ft. to ..... ft.  
 From ..... ft. to ..... ft., From ..... ft. to ..... ft.  
 GRAVEL PACK INTERVALS: From 28' ft. to 11' ft., From ..... ft. to ..... ft.  
 From ..... ft. to ..... ft., From ..... ft. to ..... ft.

6 GROUT MATERIAL: 1 Neat cement 2 Cement grout 3 Bentonite 4 Other .....  
 Grout Intervals: From 11' ft. to 3' ft., From 3' ft. to 0' ft., From ..... ft. to ..... ft.  
 What is the nearest source of possible contamination:  
 1 Septic tank 4 Lateral lines 7 Pit privy 10 Livestock pens 14 Abandoned water well  
 2 Sewer lines 5 Cess pool 8 Sewage lagoon 11 Fuel storage 15 Oil well/Gas well  
 3 Watertight sewer lines 6 Seepage pit 9 Feedyard 12 Fertilizer storage 16 Other (specify below)  
 13 Insecticide storage  
 Direction from well? North East How many feet? 160'

FROM	TO	LITHOLOGIC LOG	FROM	TO	PLUGGING INTERVALS
0	.50	Concrete			
.50	2.50	Dk gray brn gravelly sandy clay, firm, no odor.			
2.50	24.25	Med brn silty clay, moist, no odor, trace amt of caliche, Moist to wet at 18 1/2'.			
24.25	28	Tan-lt brn silty sand to sandy clay, moist to wet, no odor. soft, highly plastic.			

*F.H. OK'd by Don Taylor*

7 CONTRACTOR'S OR LANDOWNER'S CERTIFICATION: This water well was (1) constructed, (2) reconstructed, or (3) plugged under my jurisdiction and was completed on (mo/day/year) 9-4-96 and this record is true to the best of my knowledge and belief. Kansas Water Well Contractor's License No. 539. This Water Well Record was completed on (mo/day/yr) 9-6-96 under the business name of JB Environmental Drilling by (signature) James Baker