


1 LOCATION OF WATER WELL: County: Ellis Fraction: NW 1/4 NW 1/4 NW 1/4 Section Number: 35 Township Number: T 13 S Range Number: R 18 E

Distance and direction from nearest town or city street address of well if located within city?  
APPROX 150' E of CANTERBURY, 150' S of 27th STREET in Hays, KS

2 WATER WELL OWNER: Hays Medical Center  
 RR#, St. Address, Box #: 201 E 27th  
 City, State, ZIP Code: HAYS KS 67601  
 Board of Agriculture, Division of Water Resources  
 Application Number:

3 LOCATE WELL'S LOCATION WITH AN "X" IN SECTION BOX:  
 4 DEPTH OF COMPLETED WELL: 44.9 ft. ELEVATION: 2299

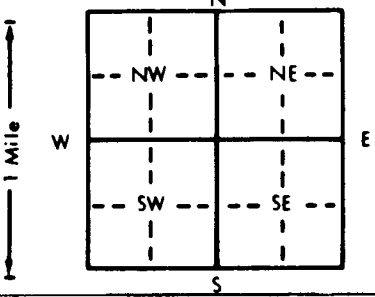

Depth(s) Groundwater Encountered 1. 22.7 ft. 2. . ft. 3. . ft.  
 WELL'S STATIC WATER LEVEL 22.0 ft. below land surface measured on mo/day/yr  
 Pump test data: Well water was . ft. after . hours pumping . gpm  
 Est. Yield . gpm: Well water was . ft. after . hours pumping . gpm  
 Bore Hole Diameter . in. to . ft., and . in. to . ft.  
 WELL WATER TO BE USED AS:  
 1 Domestic 3 Feedlot 6 Oil field water supply 9 Dewatering 12 Other (Specify below)  
 2 Irrigation 4 Industrial 7 Lawn and garden only 10 Monitoring well  
 Was a chemical/bacteriological sample submitted to Department? Yes . No ; If yes, mo/day/yr sample was submitted  
 Water Well Disinfected? Yes  No

5 TYPE OF BLANK CASING USED:  
 1 Steel 3 RMP (SR) 5 Wrought iron 8 Concrete tile CASING JOINTS: Glued . Clamped .  
 2 PVC 4 ABS 6 Asbestos-Cement 9 Other (specify below) Welded .  
 7 Fiberglass Threaded .  
 Blank casing diameter . in. to . ft., Dia . in. to . ft., Dia . in. to . ft.  
 Casing height above land surface . in., weight . lbs./ft. Wall thickness or gauge No. .

TYPE OF SCREEN OR PERFORATION MATERIAL:  
 1 Steel 3 Stainless steel 5 Fiberglass 8 RMP (SR) 10 Asbestos-cement  
 2 Brass 4 Galvanized steel 6 Concrete tile 9 ABS 11 Other (specify) .  
 7 PVC 12 None used (open hole)

SCREEN OR PERFORATION OPENINGS ARE:  
 1 Continuous slot 3 Mill slot 5 Gauzed wrapped 8 Saw cut 11 None (open hole)  
 2 Louvered shutter 4 Key punched 6 Wire wrapped 9 Drilled holes  
 7 Torch cut 10 Other (specify) .

SCREEN-PERFORATED INTERVALS: From NA ft. to . ft., From . ft. to . ft.  
 GRAVEL PACK INTERVALS: From NA ft. to . ft., From . ft. to . ft.

6 GROUT MATERIAL:  1 Neat cement 2 Cement grout  3 Bentonite 4 Other  
 Grout Intervals: From 13 ft. to 0 ft., From . ft. to . ft., From . ft. to . ft.

What is the nearest source of possible contamination:  
 1 Septic tank 4 Lateral lines 7 Pit privy 10 Livestock pens 14 Abandoned water well  
 2 Sewer lines 5 Cess pool 8 Sewage lagoon 11 Fuel storage 15 Oil well/Gas well  
 3 Watertight sewer lines 6 Seepage pit 9 Feedyard 12 Fertilizer storage 16 Other (specify below)  
 13 Insecticide storage

Direction from well? SOUTH EAST S SOUTH WEST How many feet? NA

FROM	TO	LITHOLOGIC LOG	FROM	TO	PLUGGING INTERVALS
			<u>46</u>	<u>13</u>	<u>CLORINATED &amp; TREATED SAND</u>
			<u>13</u>	<u>0</u>	<u>BENTONITE</u>

7 CONTRACTOR'S OR LANDOWNER'S CERTIFICATION: This water well was (1) constructed, (2) reconstructed, or  (3) plugged under my jurisdiction and was completed on (mo/day/year) 1/28/97 and this record is true to the best of my knowledge and belief. Kansas Water Well Contractor's License No. 003 This Water Well Record was completed on (mo/day/yr) 2/24/97 under the business name of Hays Medical Ctr by (signature) [Signature]