


1 LOCATION OF WATER WELL: County: ELLIS Fraction NE 1/4 SE 1/4 NE 1/4 Section Number 29 Township Number T 13 S Range Number R 18 E/W  
 Distance and direction from nearest town or city street address of well if located within city?  
 1001 W 36th HAYS KS 67601

2 WATER WELL OWNER: MERIDITH WASINGER  
 RR#, St. Address, Box #: 1001 W 36th ST Board of Agriculture, Division of Water Resources  
 City, State, ZIP Code: HAYS KS 67601-1505 Application Number:

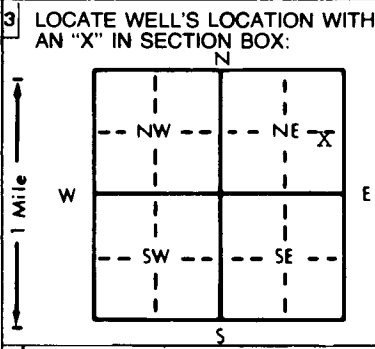

4 DEPTH OF COMPLETED WELL: 52 ft. ELEVATION: 38 ft.  
 Depth(s) Groundwater Encountered 1. 38 ft. 2. ft. 3. ft.  
 WELL'S STATIC WATER LEVEL 38 ft. below land surface measured on mo/day/yr 6-12-97  
 Pump test data: Well water was ft. after hours pumping gpm  
 Est. Yield 15 gpm: Well water was ft. after hours pumping gpm  
 Bore Hole Diameter 10 in. to 52 ft., and in. to ft.  
 WELL WATER TO BE USED AS:  
 1 Domestic 3 Feedlot 6 Oil field water supply 9 Dewatering 12 Other (Specify below)  
 2 Irrigation 4 Industrial XX Lawn and garden only 10 Monitoring well  
 Was a chemical/bacteriological sample submitted to Department? Yes No XX; If yes, mo/day/yr sample was submitted  
 Water Well Disinfected? Yes No XX

5 TYPE OF CASING USED:  
 1 Steel 3 RMP (SR) 5 Wrought iron 8 Concrete tile CASING JOINTS: Glued XX Clamped  
 XX PVC 4 ABS 6 Asbestos-Cement 9 Other (specify below) Welded  
 7 Fiberglass Threaded  
 Blank casing diameter 5 in. to 32 ft., Dia in. to ft., Dia in. to ft.  
 Casing height above land surface 18 in., weight 160 lbs./ft. Wall thickness or gauge No.  
 TYPE OF SCREEN OR PERFORATION MATERIAL:  
 1 Steel 3 Stainless steel 5 Fiberglass XX PVC 10 Asbestos-cement  
 2 Brass 4 Galvanized steel 6 Concrete tile 9 ABS 11 Other (specify)  
 12 None used (open hole)  
 SCREEN OR PERFORATION OPENINGS ARE:  
 1 Continuous slot XX Mill slot 5 Gauzed wrapped 8 Saw cut 11 None (open hole)  
 2 Louvered shutter 4 Key punched 6 Wire wrapped 9 Drilled holes  
 7 Torch cut 10 Other (specify)  
 SCREEN-PERFORATED INTERVALS: From 32 ft. to 52 ft., From ft. to ft.  
 GRAVEL PACK INTERVALS: From 25 ft. to 52 ft., From ft. to ft.

6 GROUT MATERIAL: 1 Neat cement 2 Cement grout XX Bentonite 4 Other  
 Grout Intervals: From 0 ft. to 25 ft., From ft. to ft., From ft. to ft.  
 What is the nearest source of possible contamination:  
 1 Septic tank 4 Lateral lines 7 Pit privy 10 Livestock pens 14 Abandoned water well  
 2 Sewer lines 5 Cess pool 8 Sewage lagoon 11 Fuel storage 15 Oil well/Gas well  
 3 Watertight sewer lines 6 Seepage pit 9 Feedyard 12 Fertilizer storage 16 Other (specify below)  
 13 Insecticide storage  
 Direction from well? How many feet?

FROM	TO	LITHOLOGIC LOG	FROM	TO	PLUGGING INTERVALS
0	6	SURFACE CLAY			
6	30	HARD BROWN CLAY			
30	40	FINE SAND			
40	48	MED SAND			
48	52	SOAPSTONE			

7 CONTRACTOR'S OR LANDOWNER'S CERTIFICATION: This water well was (1) constructed (2) reconstructed, or (3) plugged under my jurisdiction and was completed on (mo/day/year) 6-12-97 and this record is true to the best of my knowledge and belief. Kansas Water Well Contractor's License No. 444 This Water Well Record was completed on (mo/day/year) 6-12-97 under the business name of ANDERSON DRILLING by (signature) Andy Anderson

INSTRUCTIONS: Use typewriter or ball point pen. PLEASE PRESS FIRMLY and PRINT clearly. Please fill in blanks, underline or circle the correct answers. Send top three copies to Kansas Department of Health and Environment, Bureau of Water, Topeka, Kansas 66620-0001. Telephone: 913-296-5545. Send one to WATER WELL OWNER and retain one for your records.

OFFICE USE ONLY  
T  
R  
EW  
SEC  
1/4  
1/4  
1/4