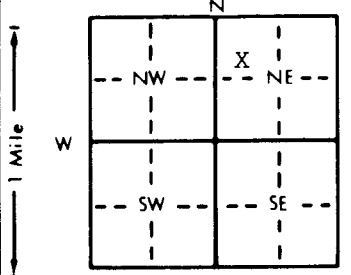


1 LOCATION OF WATER WELL: Fraction SW 1/4 NW 1/4 NE 1/4 Section Number 34 Township Number T 13 S Range Number R 18 EW

County: ELLIS
 Distance and direction from nearest town or city street address of well if located within city?
 1810 E 25th ST HAYS KS

2 WATER WELL OWNER: CHRIS APPELHANS
 RR#, St. Address, Box #: 1810 E 25th ST Board of Agriculture, Division of Water Resources
 City, State, ZIP Code: HAYS KS 67601 Application Number:

3 LOCATE WELL'S LOCATION WITH AN "X" IN SECTION BOX:

 4 DEPTH OF COMPLETED WELL: 45 ft. ELEVATION:
 Depth(s) Groundwater Encountered 1. 30 ft. 2. ft. 3. ft.
 WELL'S STATIC WATER LEVEL 30 ft. below land surface measured on mo/day/yr 9-12-97
 Pump test data: Well water was ft. after hours pumping gpm
 Est. Yield 40 gpm Well water was ft. after hours pumping gpm
 Bore Hole Diameter 10 in. to 45 ft. and in. to ft.
 WELL WATER TO BE USED AS:
 5 Public water supply 8 Air conditioning 11 Injection well
 1 Domestic 3 Feedlot 6 Oil field water supply 9 Dewatering 12 Other (Specify below)
 2 Irrigation 4 Industrial XX Lawn and garden only 10 Monitoring well
 Was a chemical/bacteriological sample submitted to Department? Yes No XX If yes, mo/day/yr sample was sub-
 mitted Water Well Disinfected? Yes No XX

5 TYPE OF BLANK CASING USED:
 1 Steel 3 RMP (SR) 5 Wrought iron 8 Concrete tile CASING JOINTS: Glued XX Clamped
 XX PVC 4 ABS 6 Asbestos-Cement 9 Other (specify below) Welded
 7 Fiberglass Threaded
 Blank casing diameter 5 in. to 25 ft. Dia in. to ft. Dia in. to ft.
 Casing height above land surface 18 in., weight 160 lbs./ft. Wall thickness or gauge No.
 TYPE OF SCREEN OR PERFORATION MATERIAL:
 XX PVC 10 Asbestos-cement
 1 Steel 3 Stainless steel 5 Fiberglass 8 RMP (SR) 11 Other (specify)
 2 Brass 4 Galvanized steel 6 Concrete tile 9 ABS 12 None used (open hole)
 SCREEN OR PERFORATION OPENINGS ARE:
 5 Gauzed wrapped 8 Saw cut 11 None (open hole)
 1 Continuous slot XX Mill slot 6 Wire wrapped 9 Drilled holes
 2 Louvered shutter 4 Key punched 7 Torch cut 10 Other (specify)
 SCREEN-PERFORATED INTERVALS: From 25 ft. to 45 ft. From ft. to ft.
 GRAVEL PACK INTERVALS: From 25 ft. to 45 ft. From ft. to ft.

6 GROUT MATERIAL: 1 Neat cement 2 Cement grout XX Bentonite 4 Other
 Grout Intervals: From 0 ft. to 25 ft. From ft. to ft. From ft. to ft.
 What is the nearest source of possible contamination:
 1 Septic tank 4 Lateral lines 7 Pit privy 10 Livestock pens 14 Abandoned water well
 2 Sewer lines 5 Cess pool 8 Sewage lagoon 11 Fuel storage 15 Oil well/Gas well
 3 Watertight sewer lines 6 Seepage pit 9 Feedyard 12 Fertilizer storage 16 Other (specify below)
 13 Insecticide storage

Direction from well?		LITHOLOGIC LOG		PLUGGING INTERVALS	
FROM	TO	FROM	TO	FROM	TO
0	4				
		SURFACE CLAY			
4	15				
		HARD YELLOW CLAY			
15	22				
		FINE SAND			
22	30				
		MED SAND			
30	40				
		LARGE SAND			
40	45				
		SOAPSTONE			

7 CONTRACTOR'S OR LANDOWNER'S CERTIFICATION: This water well was (XX) constructed, (2) reconstructed, or (3) plugged under my jurisdiction and was completed on (mo/day/year) 9-12-97 and this record is true to the best of my knowledge and belief. Kansas Water Well Contractor's License No. 444 This Water Well Record was completed on (mo/day/yr) 9-12-97 under the business name of ANDY ANDERSON DRILLING by (signature) Andy Anderson

INSTRUCTIONS: Use typewriter or ball point pen. PLEASE PRESS FIRMLY and PRINT clearly. Please fill in blanks, underline or circle the correct answers. Send to three copies to Kansas Department of Health and Environment, Bureau of Water, Topeka, Kansas 66620-0001. Telephone: 913-296-5545. Send one to WATER WELL OWNER and retain one for your records.