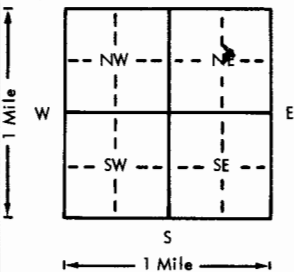
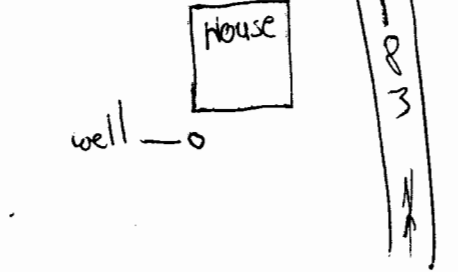


USE TYPEWRITER OR BALL POINT PEN-PRESS FIRMLY, PRINT CLEARLY.

WATER WELL RECORD  
KSA 82a-1201-1215

Kansas Department of Health and Environment-Division of Environment  
(Water well Contractors)  
Topeka, Kansas 66620

1. Location of well:		County <b>Ellis</b>	Fraction <b>SW 1/4 NE 1/4 NE 1/4</b>	Section number <b>4</b>	Township number <b>T 13 S R 18 E/W</b>	Range number
2. Distance and direction from nearest town or city: <b>4 N of Hays</b>			3. Owner of well: <b>Francis Schumacher</b>			
Street address of well location if in city:			R.R. or street: <b>Catherine Route</b>			
			City, state, zip code: <b>Hays, Kansas 67601</b>			
<input checked="" type="checkbox"/> Locate with "X" in section below: 		Sketch map: 		6. Bore hole dia. <b>5</b> in. Completion date <b>4/3/76</b> Well depth <b>53</b> ft.		
5. Type and color of material		From	To	7. <input checked="" type="checkbox"/> Cable tool <input checked="" type="checkbox"/> Rotary <input type="checkbox"/> Driven <input type="checkbox"/> Dug <input type="checkbox"/> Hollow rod <input type="checkbox"/> Jetted <input type="checkbox"/> Bored <input type="checkbox"/> Reverse rotary		
<b>Topsoil</b>		<b>1</b>	<b>3</b>	8. Use: <input checked="" type="checkbox"/> Domestic <input type="checkbox"/> Public supply <input type="checkbox"/> Industry <input type="checkbox"/> Irrigation <input type="checkbox"/> Air conditioning <input type="checkbox"/> Stock <input type="checkbox"/> Lawn <input type="checkbox"/> Oil field water <input type="checkbox"/> Other		
<b>White Rock</b>		<b>3</b>	<b>48</b>	<input checked="" type="checkbox"/> Casing: Material <b>PVC</b> Height: Above or below Threaded <input type="checkbox"/> Welded <input checked="" type="checkbox"/> Surface <b>25</b> in. RMP <input type="checkbox"/> PVC <input checked="" type="checkbox"/> Weight <input type="checkbox"/> lbs./ft. Dia. <b>5</b> in. to <b>53</b> ft. depth Wall Thickness: inches or Dia. <input type="checkbox"/> in. to <input type="checkbox"/> ft. depth gage No. <b>258</b>		
<b>Blue Shale</b>		<b>48</b>	<b>53</b>	10. Screen: Manufacturer's name <b>Jet Stream</b> Type <b>PVC</b> Dia. <b>5"</b> Slot/gauze Length <b>10'</b> Set between <b>42</b> ft. and <b>52</b> ft. <input type="checkbox"/> ft. and <input type="checkbox"/> ft. Gravel pack? <input checked="" type="checkbox"/> Yes Size range of material <b>1/4"</b>		
				11. Static water level: <input type="checkbox"/> mo./day/yr. <b>48</b> ft. below land surface Date <b>4/3/76</b>		
				12. Pumping level below land surfaces: <b>50</b> ft. after <b>3</b> hrs. pumping <b>3</b> g.p.m. <input type="checkbox"/> ft. after <input type="checkbox"/> hrs. pumping <input type="checkbox"/> g.p.m. Estimated maximum yield <b>3</b> g.p.m.		
				13. Water sample submitted: <input type="checkbox"/> Yes <input checked="" type="checkbox"/> No Date <input type="checkbox"/>		
				14. Well head completion: <input checked="" type="checkbox"/> Pitless adapter <input type="checkbox"/> inches above grade		
				15. Well grouted? <b>Yes</b> With: <input type="checkbox"/> Neat cement <input type="checkbox"/> Bentonite <input checked="" type="checkbox"/> Concrete Depth: From <b>1</b> ft. to <b>14</b> ft.		
				16. Nearest source of possible contamination: <b>None</b> ft. <input type="checkbox"/> Direction <input type="checkbox"/> Type <input type="checkbox"/> Well disinfected upon completion? <input checked="" type="checkbox"/> Yes <input type="checkbox"/> No		
				17. Pump: <input checked="" type="checkbox"/> Not installed Manufacturer's name <input type="checkbox"/> Model number <input type="checkbox"/> HP <input type="checkbox"/> Volts Length of drop pipe <input type="checkbox"/> ft. capacity <input type="checkbox"/> g.p.m. Type: <input type="checkbox"/> Submersible <input type="checkbox"/> Turbine <input type="checkbox"/> Jet <input type="checkbox"/> Reciprocating <input type="checkbox"/> Centrifugal <input type="checkbox"/> Other		
				18. Elevation: Topography: <input type="checkbox"/> Hill <input type="checkbox"/> Slope <input checked="" type="checkbox"/> Upland <input checked="" type="checkbox"/> Valley		
19. Remarks: <b>None</b>				<input checked="" type="checkbox"/> Water well contractor's certification: This well was drilled under my jurisdiction and this report is true to the best of my knowledge and belief. <b>Karst Water Well 199A</b> Business name License No. Address <b>E Hwy 40 Hays</b> Signed <b>M R Reed</b> Date <b>4/3/76</b> Authorized representative		

T 13 S R 18 E  
 Sec 4 SW NE 1/4