


1 LOCATION OF WATER WELL: County: Ellis	Fraction NW 1/4 SE 1/4 SE 1/4	Section Number 17	Township Number T 13 S	Range Number R 18 EW
---	----------------------------------	-----------------------------	---------------------------	-------------------------

Distance and direction from nearest town or city street address of well if located within city?
1 mile north on US183, 1 mile west on County Road from Intersection I-70 & US183, Hays, Ks.

2 WATER WELL OWNER: **Ellis County Municipal Landfill**
 RR#, St. Address, Box # : **P.O. Box 720**
 City, State, ZIP Code : **Hays, Kansas 67601**
 Board of Agriculture, Division of Water Resources
 Application Number:

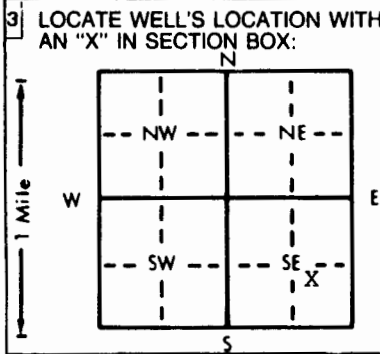

4 DEPTH OF COMPLETED WELL: **26** ft. ELEVATION: _____
 Depth(s) Groundwater Encountered 1. **18** ft. 2. _____ ft. 3. _____ ft.
 WELL'S STATIC WATER LEVEL **7.25** ft. below land surface measured on mo/day/yr **05-05-93**
 Pump test data: Well water was _____ ft. after _____ hours pumping _____ gpm
 Est. Yield _____ gpm: Well water was _____ ft. after _____ hours pumping _____ gpm
 Bore Hole Diameter: **7.5/8** in. to **26** ft., and _____ in. to _____ ft.
 WELL WATER TO BE USED AS:
 5 Public water supply 8 Air conditioning 11 Injection well
 1 Domestic 3 Feedlot 6 Oil field water supply 9 Dewatering 12 Other (Specify below)
 2 Irrigation 4 Industrial 7 Lawn and garden only **10** Monitoring well
 Was a chemical/bacteriological sample submitted to Department? Yes _____ No ; If yes, mo/day/yr sample was submitted _____
 Water Well Disinfected? Yes _____ No

5 TYPE OF BLANK CASING USED:
 1 Steel 3 RMP (SR) 5 Wrought iron 8 Concrete tile CASING JOINTS: Glued _____ Clamped _____
2 PVC 4 ABS 6 Asbestos-Cement 9 Other (specify below) Welded _____
 7 Fiberglass Threaded
 Blank casing diameter **2** in. to **16** ft., Dia _____ in. to _____ ft., Dia _____ in. to _____ ft.
 Casing height above land surface **30** in., weight _____ lbs./ft. Wall thickness or gauge No. **Sch. 40**
 TYPE OF SCREEN OR PERFORATION MATERIAL:
 1 Steel **3** Stainless steel 5 Fiberglass 7 PVC 10 Asbestos-cement
 2 Brass 4 Galvanized steel 6 Concrete tile 9 ABS 11 Other (specify) _____
 12 None used (open hole)
 SCREEN OR PERFORATION OPENINGS ARE:
 1 Continuous slot **3** Mill slot 5 Gauzed wrapped 8 Saw cut 11 None (open hole)
 2 Louvered shutter 4 Key punched 6 Wire wrapped 9 Drilled holes
 7 Torch cut 10 Other (specify) _____
 SCREEN-PERFORATED INTERVALS: From **16** ft. to **26** ft., From _____ ft. to _____ ft.
 From _____ ft. to _____ ft., From _____ ft. to _____ ft.
 GRAVEL PACK INTERVALS: From **14** ft. to **26** ft., From _____ ft. to _____ ft.
 From _____ ft. to _____ ft., From _____ ft. to _____ ft.

6 GROUT MATERIAL: 1 Neat cement **2** Cement grout **3** Bentonite 4 Other _____
 Grout Intervals: From **0** ft. to **12** ft., From **12** ft. to **14** ft., From _____ ft. to _____ ft.
 What is the nearest source of possible contamination:
 1 Septic tank 4 Lateral lines 7 Pit privy 10 Livestock pens 14 Abandoned water well
 2 Sewer lines 5 Cess pool 8 Sewage lagoon 11 Fuel storage 15 Oil well/Gas well
 3 Watertight sewer lines 6 Seepage pit 9 Feedyard 12 Fertilizer storage **16** Other (specify below)
Landfill
 Direction from well? **south** How many feet? **200**

FROM	TO	LITHOLOGIC LOG	FROM	TO	PLUGGING INTERVALS
0	9	CLY, BRN, V SLTY			
9	15	CLY, BRN, V SLTY, TR CALICHE CLSTS			MW2
15	19.5	CLY, BRN, V SLTY, TR F SND			
19.5	20	CLY, WHT/BRN, F TO M GRVL			
20	21.5	CLY, TAN/BRN, V SNDY			
21.5	25	CLY, LT WH/BRN, F TO M GRVL			
25	26	SHALE, YEL TO BL/GY, WEATHERED			

7 CONTRACTOR'S OR LANDOWNER'S CERTIFICATION: This water well was **1** constructed, **2** reconstructed, or **3** plugged under my jurisdiction and was completed on (mo/day/year) **05-04-93** and this record is true to the best of my knowledge and belief. Kansas Water Well Contractor's License No. **527** This Water Well Record was completed on (mo/day/yr) **05-11-93** under the business name of **GeoCore Services, Inc.** by (signature) *Doug Ray*