


1 LOCATION OF WATER WELL: Fraction SW 1/4 SW 1/4 SW 1/4 Section Number 18 Township Number T 13 S Range Number R 18 E/W  
 County: Ellis

Distance and direction from nearest town or city street address of well if located within city?  
3 West of Mays, Kansas

2 WATER WELL OWNER: Tom Adcock  
 RR#, St. Address, Box # : 3108 Main O'Shanter Drive Board of Agriculture, Division of Water Resources  
 City, State, ZIP Code : Mays, Kansas 67601 Application Number:

3 LOCATE WELL'S LOCATION WITH AN "X" IN SECTION BOX:

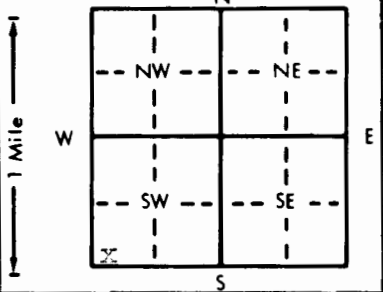

4 DEPTH OF COMPLETED WELL: 100 ft. ELEVATION: Upland

Depth(s) Groundwater Encountered 1. 87 ft. 2. . ft. 3. . ft.  
 WELL'S STATIC WATER LEVEL 60 ft. below land surface measured on mo/day/yr September 20, 1983  
 Pump test data: Well water was 62 ft. after 1 hours pumping 100 gpm  
 Est. Yield 100 gpm: Well water was . ft. after . hours pumping . gpm  
 Bore Hole Diameter 8 in. to 100 ft., and . in. to . ft.  
 WELL WATER TO BE USED AS:  
 1 Domestic 3 Feedlot 6 Oil field water supply 9 Dewatering 12 Other (Specify below)  
 2 Irrigation 4 Industrial 7 Lawn and garden only 10 Observation well  
 Was a chemical/bacteriological sample submitted to Department? Yes . No  . If yes, mo/day/yr sample was submitted  
 Water Well Disinfected? Yes  No

5 TYPE OF BLANK CASING USED: 2 5 Wrought iron 8 Concrete tile CASING JOINTS: Glued  Clamped .  
 1 Steel 3 RMP (SR) 6 Asbestos-Cement 9 Other (specify below) Welded .  
2 PVC 4 ABS 7 Fiberglass Threaded .

Blank casing diameter 5 in. to 30 ft., Dia . in. to . ft., Dia . in. to . ft.  
 Casing height above land surface 24 in., weight 160 lbs./ft. Wall thickness or gauge No. 26

TYPE OF SCREEN OR PERFORATION MATERIAL: 7 7 PVC 10 Asbestos-cement  
 1 Steel 3 Stainless steel 5 Fiberglass 8 RMP (SR) 11 Other (specify) .  
 2 Brass 4 Galvanized steel 6 Concrete tile 9 ABS 12 None used (open hole)

SCREEN OR PERFORATION OPENINGS ARE: 8 5 Gauzed wrapped 8 Saw cut 11 None (open hole)  
 1 Continuous slot 3 Mill slot 6 Wire wrapped 9 Drilled holes  
 2 Louvered shutter 4 Key punched 7 Torch cut 10 Other (specify) .

SCREEN-PERFORATED INTERVALS: From 80 ft. to 100 ft., From . ft. to . ft.  
 From . ft. to . ft., From . ft. to . ft.

GRAVEL PACK INTERVALS: From 35 ft. to 100 ft., From . ft. to . ft.  
 From . ft. to . ft., From . ft. to . ft.

6 GROUT MATERIAL: 1 1 Neat cement 2 Cement grout 3 Bentonite 4 Other .  
 Grout Intervals: From 4 ft. to 14 ft., From . ft. to . ft., From . ft. to . ft.

What is the nearest source of possible contamination: None 10 Livestock pens 14 Abandoned water well  
 1 Septic tank 4 Lateral lines 7 Pit privy 11 Fuel storage 15 Oil well/Gas well  
 2 Sewer lines 5 Cess pool 8 Sewage lagoon 12 Fertilizer storage 16 Other (specify below)  
 3 Watertight sewer lines 6 Seepage pit 9 Feedyard 13 Insecticide storage

Direction from well? How many feet?

FROM	TO	LITHOLOGIC LOG	FROM	TO	LITHOLOGIC LOG
0	3	Topsoil			
3	87	Brown clay			
87	97	Sand			
97	100	Blue shale			

7 CONTRACTOR'S OR LANDOWNER'S CERTIFICATION: This water well was (1) constructed, (2) reconstructed, or (3) plugged under my jurisdiction and was completed on (mo/day/year) October 11, 1983 and this record is true to the best of my knowledge and belief. Kansas Water Well Contractor's License No. 199 This Water Well Record was completed on (mo/day/yr) October 21, 1983 under the business name of Karst Water Well Service by (signature) Mike Karst

INSTRUCTIONS: Use typewriter or ball point pen, PLEASE PRESS FIRMLY and PRINT clearly. Please fill in blanks, underline or circle the correct answers. Send top three copies to Kansas Department of Health and Environment, Division of Environment, Environmental Geology Section, Topeka, KS 66620. Send one to WATER WELL OWNER and retain one for your records.

OFFICE USE ONLY  
 T  
 R  
 13  
 18  
 SW 1/4  
 SW 1/4  
 SW 1/4