


1 LOCATION OF WATER WELL: County: Ellis Fraction: NW 1/4 SW 1/4 SW 1/4 Section Number: 22 Township Number: T 13 S Range Number: R 18 E

Distance and direction from nearest town or city street address of well if located within city?
1/2 mile North of Hwy 183 + I-70 Interchange

2 WATER WELL OWNER: McLaren Corp
 RR#, St. Address, Box #: P.O. Box 858 Board of Agriculture, Division of Water Resources
 City, State, ZIP Code: Hays, Ks. 67601 Application Number:

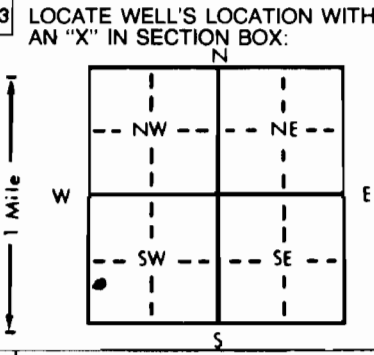

4 DEPTH OF COMPLETED WELL: 18ft ft. ELEVATION: ft.
 Depth(s) Groundwater Encountered 1. 10ft ft. 2. ft. 3. ft.
 WELL'S STATIC WATER LEVEL: 9.7' ft. below land surface measured on mo/day/yr 10-7-93
 Pump test data: Well water was ft. after hours pumping gpm
 Est. Yield gpm: Well water was ft. after hours pumping gpm
 Bore Hole Diameter: 7 1/2" in. to 18ft ft., and in. to ft.
 WELL WATER TO BE USED AS:
 5 Public water supply 8 Air conditioning 11 Injection well
 1 Domestic 3 Feedlot 6 Oil field water supply 9 Dewatering 12 Other (Specify below)
 2 Irrigation 4 Industrial 7 Lawn and garden only 10 Monitoring well
 Was a chemical/bacteriological sample submitted to Department? Yes No X; If yes, mo/day/yr sample was submitted
 Water Well Disinfected? Yes No X

5 TYPE OF BLANK CASING USED:
 1 Steel 3 RMP (SR) 5 Wrought iron 8 Concrete tile CASING JOINTS: Glued Clamped
2 PVC 4 ABS 7 Fiberglass Welded
 Blank casing diameter 2.42 in. to 8ft ft., Dia. in. to ft., Dia. in. to ft.
 Casing height above land surface Flush Mount in., weight lbs./ft. Wall thickness or gauge No. SDR-13
 TYPE OF SCREEN OR PERFORATION MATERIAL:
 1 Steel 3 Stainless steel 5 Fiberglass 8 RMP (SR) 10 Asbestos-cement Sen40
 2 Brass 4 Galvanized steel 6 Concrete tile 9 ABS 11 Other (specify)
 12 None used (open hole)
 SCREEN OR PERFORATION OPENINGS ARE:
 1 Continuous slot 3 Mill slot .010 5 Gauzed wrapped 8 Saw cut 11 None (open hole)
 2 Louvered shutter 4 Key punched 7 Torch cut 10 Other (specify)
 SCREEN-PERFORATED INTERVALS: From 18ft ft. to 8ft ft., From ft. to ft.
 From ft. to ft., From ft. to ft.
 GRAVEL PACK INTERVALS: From 18ft ft. to 6'6" ft., From ft. to ft.
 From ft. to ft., From ft. to ft.

6 GROUT MATERIAL: 1 Neat cement 2 Cement grout 3 Bentonite 4 Other
 Grout Intervals: From 6'6" ft. to 3'6" ft., From 3'6" ft. to 0 ft., From ft. to ft.
 What is the nearest source of possible contamination: 3 10 Livestock pens 14 Abandoned water well
 1 Septic tank 4 Lateral lines 7 Pit privy 11 Fuel storage 15 Oil well/Gas well
 2 Sewer lines 5 Cess pool 8 Sewage lagoon 12 Fertilizer storage 16 Other (specify below)
 3 Watertight sewer lines 6 Seepage pit 9 Feedyard 13 Insecticide storage
 Direction from well? North East How many feet? 80ft

FROM	TO	LITHOLOGIC LOG	FROM	TO	PLUGGING INTERVALS
0	1.50	Asphalt			
1.50	1.95	Hard to dk Brown silty clay			
1.95	5.5	lt Tan sandy silty clay w/ caliche w/ fine gravel sand			
5.5	10.5	Tan silty sand to sandy silts, caliche "			
10.5	15.25	Tan sand; fine-very coarse grained, poorly sorted, subrounded grains			
15.25	18.0	Gray to yellow Brown iron oxide stained clayey shale			

7 CONTRACTOR'S OR LANDOWNER'S CERTIFICATION: This water well was (1) constructed, (2) reconstructed, or (3) plugged under my jurisdiction and was completed on (mo/day/year) 10-7-93 and this record is true to the best of my knowledge and belief. Kansas Water Well Contractor's License No. 539 This Water Well Record was completed on (mo/day/yr) 10-14-93 under the business name of GB Environmental Drilling by (signature) James Becker