


1 LOCATION OF WATER WELL: County: Ellis Fraction: SE 1/4 SW 1/4 Section Number: 25 Township Number: T 13 S Range Number: R 18 E/W

Distance and direction from nearest town or city street address of well if located within city?  
2 1/2 East of Hays, Kansas 67671

2 WATER WELL OWNER: Don Gross  
 RR#, St. Address, Box #: Box 124  
 City, State, ZIP Code: Victoria, Kansas 67671  
 Board of Agriculture, Division of Water Resources  
 Application Number:

3 LOCATE WELL'S LOCATION WITH AN "X" IN SECTION BOX: 4 DEPTH OF COMPLETED WELL: 35 ft. ELEVATION: Upland

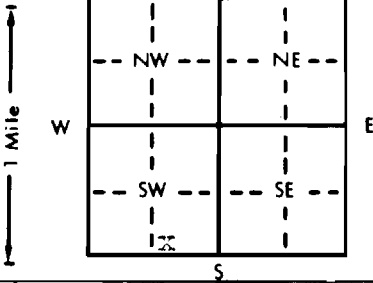

Depth(s) Groundwater Encountered 1. 18 ft. 2. 10 ft. 3. 10 ft.  
 WELL'S STATIC WATER LEVEL 21 ft. below land surface measured on mo/day/yr October 5, 1983  
 Pump test data: Well water was 21 ft. after 1 hours pumping 10 gpm  
 Est. Yield 10 gpm: Well water was 10 ft. after 10 hours pumping 10 gpm  
 Bore Hole Diameter 9 in. to 35 ft., and 9 in. to 35 ft.  
 WELL WATER TO BE USED AS:  
 1 Domestic 3 Feedlot 6 Oil field water supply 9 Dewatering 12 Other (Specify below)  
 2 Irrigation 4 Industrial 7 Lawn and garden only 10 Observation well  
 Was a chemical/bacteriological sample submitted to Department? Yes X No X; If yes, mo/day/yr sample was submitted 10  
 Water Well Disinfected? Yes X No X

5 TYPE OF BLANK CASING USED: 2 5 Wrought iron 8 Concrete tile CASING JOINTS: Glued X Clamped X  
 1 Steel 3 RMP (SR) 6 Asbestos-Cement 9 Other (specify below) Welded X  
2 PVC 4 ABS 7 Fiberglass Threaded X

Blank casing diameter 5 in. to 25 ft., Dia. 5 in. to 25 ft., Dia. 5 in. to 25 ft.  
 Casing height above land surface 16 in., weight 160 lbs./ft. Wall thickness or gauge No. 25

TYPE OF SCREEN OR PERFORATION MATERIAL: 7 7 PVC 10 Asbestos-cement  
 1 Steel 3 Stainless steel 5 Fiberglass 8 RMP (SR) 11 Other (specify)  
 2 Brass 4 Galvanized steel 6 Concrete tile 9 ABS 12 None used (open hole)

SCREEN OR PERFORATION OPENINGS ARE: 8 5 Gauzed wrapped 8 Saw cut 11 None (open hole)  
 1 Continuous slot 3 Mill slot 6 Wire wrapped 9 Drilled holes  
 2 Louvered shutter 4 Key punched 7 Torch cut 10 Other (specify)

SCREEN-PERFORATED INTERVALS: From 25 ft. to 35 ft., From 25 ft. to 35 ft.  
 GRAVEL PACK INTERVALS: From 14 ft. to 35 ft., From 14 ft. to 35 ft.

6 GROUT MATERIAL: 1 1 Neat cement 2 Cement grout 3 Bentonite 4 Other  
 Grout Intervals: From 4 ft. to 14 ft., From 4 ft. to 14 ft.

What is the nearest source of possible contamination: none  
 1 Septic tank 4 Lateral lines 7 Pit privy 10 Livestock pens 14 Abandoned water well  
 2 Sewer lines 5 Cess pool 8 Sewage lagoon 11 Fuel storage 15 Oil well/Gas well  
 3 Watertight sewer lines 6 Seepage pit 9 Feedyard 12 Fertilizer storage 16 Other (specify below)  
 13 Insecticide storage

Direction from well? How many feet?

FROM	TO	LITHOLOGIC LOG	FROM	TO	LITHOLOGIC LOG
0	3	Topsoil			
3	13	<u>0/1</u> Brown clay			
13	18	<u>2/8</u> White rock			
18	27	<u>0/5</u> Sand			
27	32	<u>0/1</u> Gray clay			
32	35	<u>0/9</u> Shale			

7 CONTRACTOR'S OR LANDOWNER'S CERTIFICATION: This water well was (1) constructed, (2) reconstructed, or (3) plugged under my jurisdiction and was completed on (mo/day/year) October 5, 1983 and this record is true to the best of my knowledge and belief. Kansas Water Well Contractor's License No. 199 This Water Well Record was completed on (mo/day/yr) October 14, 1983 under the business name of Karst Water Well Service by (signature) Neil Karst

INSTRUCTIONS: Use typewriter or ball point pen, PLEASE PRESS FIRMLY and PRINT clearly. Please fill in blanks, underline or circle the correct answers. Send top three copies to Kansas Department of Health and Environment, Division of Environment, Environmental Geology Section, Topeka, KS 66620. Send one to WATER WELL OWNER and retain one for your records.

OFFICE USE ONLY  
 T  
 13  
 R  
 18  
 SEC.  
 25  
 SW 1/4  
 SE 1/4  
 SW 1/4

19