


WATER WELL RECORD Form WWC-5 KSA 82a-1212

1 LOCATION OF WATER WELL: County: Ellis Fraction: SW 1/4 SE 1/4 SW 1/4 Section Number: 27 Township Number: T 13 S Range Number: R 18 EW

Distance and direction from nearest town or city street address of well if located within city? NW corner of Broadway & 27th Street

2 WATER WELL OWNER: Henry Schwaller, Jr. - Frontier Quick Mart Board of Agriculture, Division of Water Resources RR#, St. Address, Box #: 1500 Vine Application Number: City, State, ZIP Code: Hays, Ks. 67601

3 LOCATE WELL'S LOCATION WITH AN "X" IN SECTION BOX:

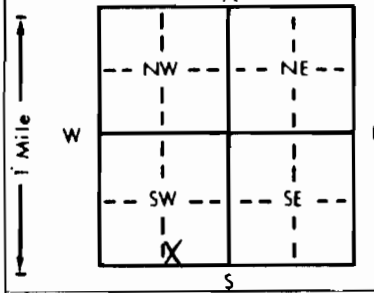

4 DEPTH OF COMPLETED WELL: 30 ft. ELEVATION: NA. WELL'S STATIC WATER LEVEL: 22.55 ft. below land surface measured on mo/day/yr: 04-18-94. Pump test data: Well water was ... ft. after ... hours pumping ... gpm. Est. Yield ... gpm: Well water was ... ft. after ... hours pumping ... gpm. Bore Hole Diameter: 7 5/8 in. to 30 ft., and ... in. to ... ft. WELL WATER TO BE USED AS: 10 Monitoring well. Was a chemical/bacteriological sample submitted to Department? Yes ... No X ...; if yes, mo/day/yr sample was submitted. Water Well Disinfected? Yes ... No X

5 TYPE OF CASING USED: 2 PVC. Blank casing diameter: 2 in. to 15 ft. Dia ... in. to ... ft. Dia ... in. to ... ft. Casing height above land surface: 0 in., weight ... lbs./ft. Wall thickness or gauge No. sch. 40. TYPE OF SCREEN OR PERFORATION MATERIAL: 7 PVC. SCREEN OR PERFORATION OPENINGS ARE: 3 Mill slot.

SCREEN-PERFORATED INTERVALS: From 30 ft. to 15 ft. GRAVEL PACK INTERVALS: From 30 ft. to 13 ft.

6 GROUT MATERIAL: 2 Cement grout, 3 Bentonite. Grout Intervals: From 0 ft. to 11 ft., From 11 ft. to 13 ft., From ... ft. to ... ft. What is the nearest source of possible contamination: 11 Fuel storage. Direction from well? northwest. How many feet? 50.

Table with columns: FROM, TO, LITHOLOGIC LOG, FROM, TO, PLUGGING INTERVALS. Log entries include concrete, snd & grvl fill, cly, dk-med brn, v slty, tr of snd szd calic, damp; cly, lt oran brn, v slty, sl-mod calic mat thruout, damp; cly, med oran brn, v slty, mod snd-grvl szd calic; tr of chert clsts, damp.

7 CONTRACTOR'S OR LANDOWNER'S CERTIFICATION: This water well was (1) constructed, (2) reconstructed, or (3) plugged under my jurisdiction and was completed on (mo/day/year) 04-07-94 and this record is true to the best of my knowledge and belief. Kansas Water Well Contractor's License No. 527. This Water Well Record was completed on (mo/day/yr) 04-21-94 under the business name of GeoCore Services, Inc. by (signature) Dal ...

INSTRUCTIONS: Use typewriter or ball point pen. PLEASE PRESS FIRMLY and PRINT clearly. Please fill in blanks, underline or circle the correct answers. Send top three copies to Kansas Department of Health and Environment, Bureau of Water, Topeka, Kansas 66620-0001. Telephone: 913-296-5545. Send one to WATER WELL OWNER and retain one for your records.