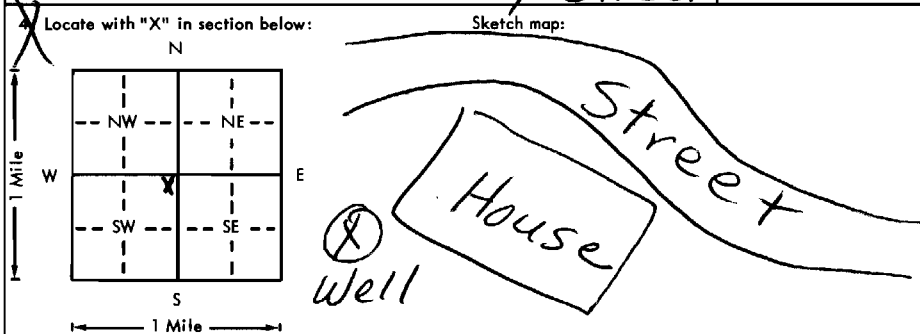


USE TYPEWRITER OR BALL POINT PEN-PRESS FIRMLY, PRINT CLEARLY.

WATER WELL RECORD  
KSA 82a-1201-1215

Kansas Department of Health and Environment-Division of Environment (Water well Contractors) Topeka, Kansas 66620

1. Location of well:	County <u>Ellis</u>	Fraction <u>SW</u> <u>NE 1/4 NE 1/4 SE 1/4</u>	Section number <u>27</u>	Township number T <u>13</u> S <u>18</u> E <u>10</u>	Range number																		
2. Distance and direction from nearest town or city: Street address of well location if in city: <u>Parkway Street</u>			3. Owner of well: <u>Darrell Seibel</u> R.R. or street: <u>Parkway Street</u> City, state, zip code: <u>Hays, Kansas 67601</u>																				
4. Locate with "X" in section below: 			6. Bore hole dia. <u>5</u> in. Completion date <u>10/11/75</u> Well depth <u>35</u> ft.																				
5. Type and color of material			7. <input type="checkbox"/> Cable tool <input checked="" type="checkbox"/> Rotary <input type="checkbox"/> Driven <input type="checkbox"/> Dug <input type="checkbox"/> Hollow rod <input type="checkbox"/> Jetted <input type="checkbox"/> Bored <input type="checkbox"/> Reverse rotary																				
<table border="1" style="width:100%; border-collapse: collapse;"> <thead> <tr> <th style="width:80%;"></th> <th style="width:10%;">From</th> <th style="width:10%;">To</th> </tr> </thead> <tbody> <tr> <td><u>Topsoil</u></td> <td><u>0</u></td> <td><u>6</u></td> </tr> <tr> <td><u>Subsoil</u></td> <td><u>6</u></td> <td><u>18</u></td> </tr> <tr> <td><u>Brown Clay</u></td> <td><u>18</u></td> <td><u>23</u></td> </tr> <tr> <td><u>Gravel</u></td> <td><u>23</u></td> <td><u>33</u></td> </tr> <tr> <td><u>Blue Shale</u></td> <td><u>33</u></td> <td><u>35</u></td> </tr> </tbody> </table>				From	To	<u>Topsoil</u>	<u>0</u>	<u>6</u>	<u>Subsoil</u>	<u>6</u>	<u>18</u>	<u>Brown Clay</u>	<u>18</u>	<u>23</u>	<u>Gravel</u>	<u>23</u>	<u>33</u>	<u>Blue Shale</u>	<u>33</u>	<u>35</u>	8. Use: <input type="checkbox"/> Domestic <input type="checkbox"/> Public supply <input type="checkbox"/> Industry <input type="checkbox"/> Irrigation <input type="checkbox"/> Air conditioning <input type="checkbox"/> Stock <input checked="" type="checkbox"/> Lawn <input type="checkbox"/> Oil field water <input type="checkbox"/> Other		
	From	To																					
<u>Topsoil</u>	<u>0</u>	<u>6</u>																					
<u>Subsoil</u>	<u>6</u>	<u>18</u>																					
<u>Brown Clay</u>	<u>18</u>	<u>23</u>																					
<u>Gravel</u>	<u>23</u>	<u>33</u>																					
<u>Blue Shale</u>	<u>33</u>	<u>35</u>																					
			9. Casing: Material <u>PVC</u> Height <u>Above or below</u> Threaded <input type="checkbox"/> Welded <input checked="" type="checkbox"/> Surface <u>15</u> in. RMP <input type="checkbox"/> PVC <input checked="" type="checkbox"/> Weight <u>2.5</u> lbs./ft. Dia. <u>5</u> in. to <u>35</u> ft. depth Wall Thickness: inches or Dia. <u>5</u> in. to <u>35</u> ft. depth gage No. <u>258</u>																				
			10. Screens: Manufacturer's name <u>Jet stream</u> Type <u>PVC</u> Dia. <u>5"</u> Slot/gauze <u>10'</u> Length <u>10'</u> Set between <u>25</u> ft. and <u>35</u> ft. Gravel pack? <u>Yes</u> Size range of material <u>1/4-1/2</u>																				
			11. Static water level: <u>15</u> ft. below land surface Date <u>10/11/75</u>																				
			12. Pumping level below land surfaces: <u>15</u> ft. after <u>1</u> hrs. pumping <u>10</u> g.p.m. <u>    </u> ft. after <u>    </u> hrs. pumping <u>    </u> g.p.m. Estimated maximum yield <u>20</u> g.p.m.																				
			13. Water sample submitted: <u>    </u> mo./day/yr. <input type="checkbox"/> Yes <input checked="" type="checkbox"/> No Date <u>    </u>																				
			14. Well head completion: <input type="checkbox"/> Pitless adapter <u>15</u> inches above grade																				
			15. Well grouted? <u>Yes</u> With: <input type="checkbox"/> Neat cement <input type="checkbox"/> Bentonite <input checked="" type="checkbox"/> Concrete Depth: From <u>2</u> ft. to <u>10</u> ft.																				
			16. Nearest source of possible contamination: <u>None</u> ft. <u>    </u> Direction <u>    </u> Type <u>    </u> Well disinfected upon completion? <input checked="" type="checkbox"/> Yes <input type="checkbox"/> No																				
			17. Pump: <u>Not installed</u> Manufacturer's name <u>F&amp;W</u> Model number <u>7BR7</u> HP <u>3/4</u> Volts <u>220</u> Length of drop pipe <u>30</u> ft. capacity <u>20</u> g.p.m. Type: <input checked="" type="checkbox"/> Submersible <input type="checkbox"/> Turbine <input type="checkbox"/> Jet <input type="checkbox"/> Reciprocating <input type="checkbox"/> Centrifugal <input type="checkbox"/> Other																				
18. Elevation:			19. Remarks:																				
Topography: <input type="checkbox"/> Hill <input checked="" type="checkbox"/> Slope <input type="checkbox"/> Upland <input type="checkbox"/> Valley			<u>None</u>																				
			20. Water well contractor's certification: This well was drilled under my jurisdiction and this report is true to the best of my knowledge and belief. <u>Karst Water Well 199A</u> Business name <u>    </u> License No. <u>    </u> Address <u>E. Hwy 40 Hays</u> Signed <u>    </u> Date <u>10/11/75</u> Authorized representative																				

Forward the white, blue and pink copies to the Department of Health and Environment

Form WWC-5