


1 LOCATION OF WATER WELL: County: ELLIS Fraction: SW 1/4 NE 1/4 NE 1/4 Section Number: 207334 Township Number: T13 Souths Range Number: R18W-11E
 Distance and direction from nearest town or city street address of well if located within city? 27

2 WATER WELL OWNER: ALVIN M. ERBERT
 RR#, St. Address, Box #: 1607 E. 28th St. TERRACE Board of Agriculture, Division of Water Resources
 City, State, ZIP Code: HAYS KANSAS 67601 Application Number:

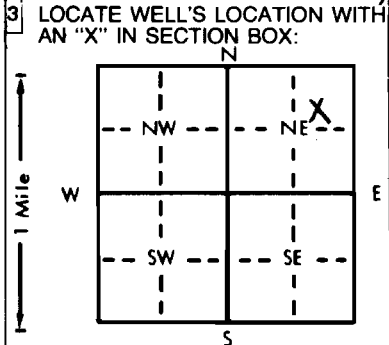

4 DEPTH OF COMPLETED WELL: 45.6 ft. ELEVATION:
 Depth(s) Groundwater Encountered: 22.3 ft. 2. 26 ft. 3. 49/30/90
 WELL'S STATIC WATER LEVEL: 22.3 ft. below land surface measured on mo/day/yr
 Pump test data: Well water was 25 ft. after 1 hours pumping 5 gpm
 Est. Yield: 7 gpm: Well water was 45.6 ft. after 1 hours pumping 5 gpm
 Bore Hole Diameter: 7 in. to 45.6 ft., and 1 in. to 1 ft.
 WELL WATER TO BE USED AS:
 1 Domestic 3 Feedlot 6 Oil field water supply 9 Dewatering 12 Other (Specify below)
 2 Irrigation 4 Industrial 7 Lawn and garden only 10 Monitoring well
 Was a chemical/bacteriological sample submitted to Department? Yes No : If yes, mo/day/yr sample was submitted
 Water Well Disinfected? Yes No

5 TYPE OF BLANK CASING USED:
 1 Steel 3 RMP (SR) 5 Wrought iron 8 Concrete tile CASING JOINTS: Glued Clamped
2 PVC 4 ABS 6 Asbestos-Cement 9 Other (specify below) Welded
 7 Fiberglass Threaded
 Blank casing diameter: 4 in. to 45.6 ft., Dia. in. to ft., Dia. in. to ft.
 Casing height above land surface: 12 in., weight lbs./ft. Wall thickness or gauge No.
 TYPE OF SCREEN OR PERFORATION MATERIAL:
 1 Steel 3 Stainless steel 5 Fiberglass 8 RMP (SR) 10 Asbestos-cement
 2 Brass 4 Galvanized steel 6 Concrete tile 9 ABS 12 None used (open hole)
 SCREEN OR PERFORATION OPENINGS ARE:
 1 Continuous slot 3 Mill slot 5 Gauzed wrapped 8 Saw cut 11 None (open hole)
 2 Louvered shutter 4 Key punched 6 Wire wrapped 9 Drilled holes
 7 Torch cut 10 Other (specify)
 SCREEN-PERFORATED INTERVALS: From 20 ft. to 45.6 ft., From ft. to ft.
 GRAVEL PACK INTERVALS: From 10 ft. to 45.6 ft., From ft. to ft.

6 GROUT MATERIAL: 1 Neat cement 2 Cement grout 3 Bentonite 4 Other
 Grout Intervals: From 0 ft. to 10 ft., From ft. to ft., From ft. to ft.
 What is the nearest source of possible contamination:
 1 Septic tank 4 Lateral lines 7 Pit privy 10 Livestock pens 14 Abandoned water well
 2 Sewer lines 5 Cess pool 8 Sewage lagoon 11 Fuel storage 15 Oil well/Gas well
3 Watertight sewer lines 6 Seepage pit 9 Feedyard 12 Fertilizer storage 16 Other (specify below)
 13 Insecticide storage
 Direction from well? north How many feet? 62

FROM	TO	LITHOLOGIC LOG	FROM	TO	PLUGGING INTERVALS
0	5	SOIL			
5	15	CLAY			
15	23	mud			
23	25	water			
25	26	rock			
26	28	water			
28	29	rock and sand			
30	33	rock			
33	40	CLAY and sand			
40	42	water			
42	45.6	CLAY			

7 CONTRACTOR'S OR LANDOWNER'S CERTIFICATION: This water well was (1) constructed, (2) reconstructed, or (3) plugged under my jurisdiction and was completed on (mo/day/year) 9/29/90 and this record is true to the best of my knowledge and belief. Kansas Water Well Contractor's License No. 521 This Water Well Record was completed on (mo/day/yr) under the business name of Protechs Drilling Serv by (signature) Jonathan Protechs

OFFICE USE ONLY