


1 LOCATION OF WATER WELL: County: Ellis Fraction: SE 1/4 SE 1/4 NE 1/4 Section Number: 27 Township Number: T 13 S Range Number: R 18 E/W

Distance and direction from nearest town or city street address of well if located within city?
2920 Barclay St. Hays Ks

2 WATER WELL OWNER: Henry Pfannenstiel
 RR#, St. Address, Box #: 2920 Barclay St
 City, State, ZIP Code: Hays Ks 67601
 Board of Agriculture, Division of Water Resources
 Application Number:

3 LOCATE WELL'S LOCATION WITH AN "X" IN SECTION BOX:

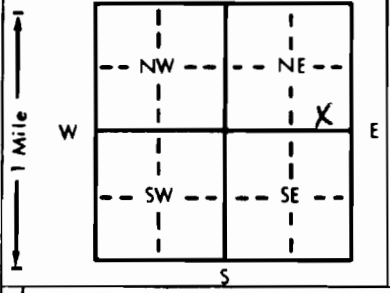

4 DEPTH OF COMPLETED WELL: 59 ft. ELEVATION:
 Depth(s) Groundwater Encountered 1. 38 ft. 2. ft. 3. ft.
 WELL'S STATIC WATER LEVEL 39 ft. below land surface measured on mo/day/yr 9-29-92
 Pump test data: Well water was 21 ft. after 1 hours pumping 20 gpm
 Est. Yield 20 gpm; Well water was ft. after hours pumping gpm
 Bore Hole Diameter 10 in. to ft., and in. to ft.
 WELL WATER TO BE USED AS:
 1 Domestic 3 Feedlot 6 Oil field water supply 9 Dewatering 12 Other (Specify below)
 2 Irrigation 4 Industrial 7 Lawn and garden only 10 Monitoring well
 Was a chemical/bacteriological sample submitted to Department? Yes No; If yes, mo/day/yr sample was submitted
 Water Well Disinfected Yes No

5 TYPE OF BLANK CASING USED:
 1 Steel 3 RMP (SR) 5 Wrought iron 8 Concrete tile CASING JOINTS: Glued Clamped
 2 PVC 4 ABS 6 Asbestos-Cement 9 Other (specify below) Welded
 7 Fiberglass Threaded

Blank casing diameter 5 in. to ft., Dia. in. to ft., Dia. in. to ft.
 Casing height above land surface 18 in., weight lbs./ft. Wall thickness or gauge No. S.D.R. 26

TYPE OF SCREEN OR PERFORATION MATERIAL:
 1 Steel 3 Stainless steel 5 Fiberglass 7 PVC 10 Asbestos-cement
 2 Brass 4 Galvanized steel 6 Concrete tile 8 RMP (SR) 11 Other (specify)
 12 None used (open hole)

SCREEN OR PERFORATION OPENINGS ARE:
 1 Continuous slot Mill slot 5 Gauzed wrapped 8 Saw cut 11 None (open hole)
 2 Louvered shutter 4 Key punched 6 Wire wrapped 9 Drilled holes
 7 Torch cut 10 Other (specify)

SCREEN-PERFORATED INTERVALS: From 39 ft. to 59 ft., From ft. to ft.
 From ft. to ft., From ft. to ft.
 GRAVEL PACK INTERVALS: From 30 ft. to 59 ft., From ft. to ft.
 From ft. to ft., From ft. to ft.

6 GROUT MATERIAL: 1 Neat cement Cement grout 3 Bentonite 4 Other
 Grout Intervals: From 4 ft. to 24 ft., From ft. to ft., From ft. to ft.

What is the nearest source of possible contamination:
 1 Septic tank 4 Lateral lines 7 Pit privy 10 Livestock pens 14 Abandoned water well
 2 Sewer lines 5 Cess pool 8 Sewage lagoon 11 Fuel storage 15 Oil well/Gas well
 3 Watertight sewer lines 6 Seepage pit 9 Feedyard 12 Fertilizer storage 16 Other (specify below)
 13 Insecticide storage
 Direction from well? South How many feet? 60-80

FROM	TO	LITHOLOGIC LOG	FROM	TO	PLUGGING INTERVALS
0	10	Top soil			
10	38	brown clay			
38	54	brown clay mixed with fine grey sand			
54	59	shale			

7 CONTRACTOR'S OR LANDOWNER'S CERTIFICATION: This water well was (1) constructed, (2) reconstructed, or (3) plugged under my jurisdiction and was completed on (mo/day/year) 9-29-92 and this record is true to the best of my knowledge and belief. Kansas Water Well Contractor's License No. 276 This Water Well Record was completed on (mo/day/yr) 9-29-92 under the business name of BUEA Water Well Drilling by (signature) John Stea