


1 LOCATION OF WATER WELL: County: Ellis Fraction: SE 1/4 SE 1/4 NW 1/4 Section Number: 28 Township Number: T 13 S Range Number: R 18 E(W)

Distance and direction from nearest town or city street address of well if located within city?
In Hays

2 WATER WELL OWNER: Larry Wilton
RR#, St. Address, Box #: 3303 Country Lane Board of Agriculture, Division of Water Resources
City, State, ZIP Code: Hays, KS Application Number:

3 LOCATE WELL'S LOCATION WITH AN "X" IN SECTION BOX:

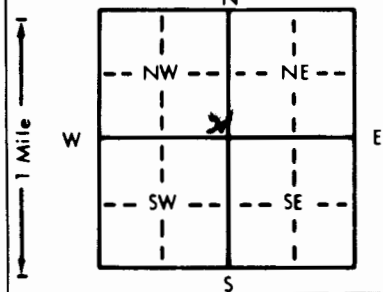

4 DEPTH OF COMPLETED WELL: 32 ft. ELEVATION:

Depth(s) Groundwater Encountered 1. 20 ft. 2. ft. 3. ft.

WELL'S STATIC WATER LEVEL: 23 ft. below land surface measured on mo/day/yr 5/25/85

Pump test data: Well water was ft. after hours pumping gpm

Est. Yield: 8+ gpm Well water was ft. after hours pumping gpm

Bore Hole Diameter: 10 1/4 in. to 32 in. to in. to in. to ft.

WELL WATER TO BE USED AS: 5 Public water supply 8 Air conditioning 11 Injection well

1 Domestic 3 Feedlot 6 Oil field water supply 9 Dewatering 12 Other (Specify below)

2 Irrigation 4 Industrial Lawn and garden only 10 Observation well

Was a chemical/bacteriological sample submitted to Department? Yes No X If yes, mo/day/yr sample was submitted

Water Well Disinfected? Yes No

5 TYPE OF BLANK CASING USED: 5 Wrought iron 8 Concrete tile CASING JOINTS: Glued X Clamped

1 Steel 3 RMP (SR) 6 Asbestos-Cement 9 Other (specify below) Welded

2 PVC 4 ABS 7 Fiberglass Threaded

Blank casing diameter: 5.56 in. to 22 in. Dia. in. to in. Dia. in. to in. to ft.

Casing height above land surface: 6 inches in., weight lbs./ft. Wall thickness or gauge No. SDR-26

TYPE OF SCREEN OR PERFORATION MATERIAL: 7 PVC 10 Asbestos-cement

1 Steel 3 Stainless steel 5 Fiberglass 8 RMP (SR) 11 Other (specify)

2 Brass 4 Galvanized steel 6 Concrete tile 9 ABS 12 None used (open hole)

SCREEN OR PERFORATION OPENINGS ARE: 5 Gauzed wrapped 8 Saw cut 11 None (open hole)

1 Continuous slot 3 Mill slot 6 Wire wrapped 9 Drilled holes

2 Louvered shutter 4 Key punched 7 Torch cut 10 Other (specify)

SCREEN-PERFORATED INTERVALS: From 32 ft. to 22 ft., From ft. to ft.

GRAVEL PACK INTERVALS: From 32 ft. to 10 ft., From ft. to ft.

6 GROUT MATERIAL: 1 Neat cement 2 Cement grout 3 Bentonite 4 Other

Grout intervals: From 10 ft. to 0 ft., From ft. to ft., From ft. to ft.

What is the nearest source of possible contamination: 10 Livestock pens 14 Abandoned water well

1 Septic tank 4 Lateral lines 7 Pit privy 11 Fuel storage 15 Oil well/Gas well

2 Sewer lines 5 Cess pool 8 Sewage lagoon 12 Fertilizer storage 16 Other (specify below)

Watertight sewer lines Seepage pit 9 Feedyard 13 Insecticide storage

Direction from well? Northwest How many feet? 70 ft

FROM	TO	LITHOLOGIC LOG	FROM	TO	LITHOLOGIC LOG
0	2	Top soil			
2	5	yellow clay			
5	11	yellow clay w/ some limestone & gravel			
11	22	fine sand w/ yellow clay			
22	30	medium to coarse sand & gravel			
30	32	shale			

7 CONTRACTOR'S OR LANDOWNER'S CERTIFICATION: This water well was (1) constructed, (2) reconstructed, or (3) plugged under my jurisdiction and was completed on (mo/day/year) 5/25/85 and this record is true to the best of my knowledge and belief. Kansas

Water Well Contractor's License No. 455 This Water Well Record was completed on (mo/day/yr) 6/10/85 under the business name of Shaw Pump & Supply by (signature) Jerman Becker

INSTRUCTIONS: Use typewriter or ball point pen, PLEASE PRESS FIRMLY and PRINT clearly. Please fill in blanks, underline or circle the correct answers. Send top three copies to Kansas Department of Health and Environment, Division of Environment, Environmental Geology Section, Topeka, KS 66620. Send one to WATER WELL OWNER and retain one for your records.