


1 LOCATION OF WATER WELL: Fraction NE 1/4 NE 1/4 SW 1/4 Section Number 28 Township Number T 13 S Range Number R 18 EW  
 County: Ellis

Distance and direction from nearest town or city street address of well if located within city?  
In Hays

2 WATER WELL OWNER: Bob Schibi  
 RR#, St. Address, Box #: 301 Country Lane Board of Agriculture, Division of Water Resources  
 City, State, ZIP Code: Hays, KS 67601 Application Number:

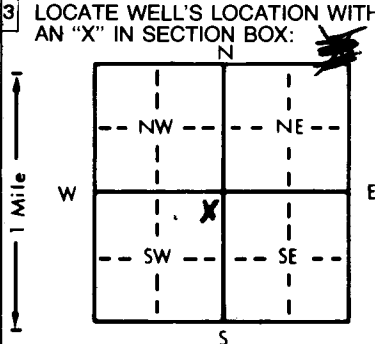

4 DEPTH OF COMPLETED WELL: 50 ft. ELEVATION:  
 Depth(s) Groundwater Encountered 1. 29 ft. 2. ft. 3. ft.  
 WELL'S STATIC WATER LEVEL 23 ft. below land surface measured on mo/day/yr  
 Pump test data: Well water was ft. after hours pumping gpm  
 Est. Yield gpm: Well water was ft. after hours pumping gpm  
 Bore Hole Diameter: 10 1/4 in. to 50 ft., and in. to ft.  
 WELL WATER TO BE USED AS:  
 5 Public water supply 8 Air conditioning 11 Injection well  
 1 Domestic 3 Feedlot 6 Oil field water supply 9 Dewatering 12 Other (Specify below)  
 2 Irrigation 4 Industrial 7 Lawn and garden only 10 Observation well  
 Was a chemical/bacteriological sample submitted to Department? Yes.....No..... If yes, mo/day/yr sample was submitted  
 Water Well Disinfected? Yes X

5 TYPE OF BLANK CASING USED:  
 1 Steel 3 RMP (SR) 5 Wrought iron 8 Concrete tile CASING JOINTS: Glued.....Clamped.....  
2 PVC 4 ABS 6 Asbestos-Cement 9 Other (specify below) Welded.....  
 7 Fiberglass (Refr) Threaded.....  
 Blank casing diameter 5.56 in. to 25 ft., Dia 5.56 in. to 50 ft ft., Dia in. to ft.  
 Casing height above land surface 18 in., weight lbs./ft. Wall thickness or gauge No. SDR 26  
 TYPE OF SCREEN OR PERFORATION MATERIAL:  
 1 Steel 3 Stainless steel 5 Fiberglass 8 RMP (SR) 10 Asbestos-cement  
 2 Brass 4 Galvanized steel 6 Concrete tile 9 ABS 11 Other (specify)  
 12 None used (open hole)  
 SCREEN OR PERFORATION OPENINGS ARE:  
 1 Continuous slot 3 Mill slot 5 Gauzed wrapped 8 Saw cut 11 None (open hole)  
 2 Louvered shutter 4 Key punched 6 Wire wrapped 9 Drilled holes  
 7 Torch cut 10 Other (specify)  
 SCREEN-PERFORATED INTERVALS: From 25 ft. to 50 ft., From ft. to ft.  
 GRAVEL PACK INTERVALS: From 20 ft. to 50 ft., From ft. to ft.

6 GROUT MATERIAL: 1 Neat cement 2 Cement grout 3 Bentonite 4 Other Clay backfill  
 Grout Intervals: From 0 ft. to 10 ft., From 11 ft. to 25 ft., From ft. to ft.  
 What is the nearest source of possible contamination:  
 1 Septic tank 4 Lateral lines 7 Pit privy 10 Livestock pens 14 Abandoned water well  
 2 Sewer lines 5 Cess pool 8 Sewage lagoon 11 Fuel storage 15 Oil well/Gas well  
3 Watertight sewer lines 6 Seepage pit 9 Feedyard 12 Fertilizer storage 16 Other (specify below)  
 13 Insecticide storage  
 Direction from well? 300 ft How many feet?

FROM	TO	LITHOLOGIC LOG	FROM	TO	LITHOLOGIC LOG
0	70	Top soil			
7	25	Clay & Brown dirt mixed; some fine sand			
25	32	Gravel & Clay bridges in between			
32	45	Gravel			
45	50	Shale			

7 CONTRACTOR'S OR LANDOWNER'S CERTIFICATION: This water well was (1) constructed, (2) reconstructed, or (3) plugged under my jurisdiction and was completed on (mo/day/year) 3-14-84 and this record is true to the best of my knowledge and belief. Kansas Water Well Contractor's License No. 455 This Water Well Record was completed on (mo/day/yr) 4/9/84 under the business name of TransPump Supply by (signature) James Becker

INSTRUCTIONS: Use typewriter or ball point pen, PLEASE PRESS FIRMLY and PRINT clearly. Please fill in blanks underline or circle the correct answers. Send top three copies to Kansas Department of Health and Environment, Division of Environment, Environmental Geology Section, Topeka, KS 66620. Send one to WATER WELL OWNER and retain one for your records.