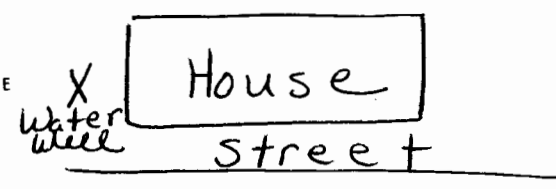


USE TYPEWRITER OR BALL POINT PEN-PRESS FIRMLY, PRINT CLEARLY.

WATER WELL RECORD  
KSA 82a-1201-1215

Kansas Department of Health and Environment-Division of Environment  
(Water well Contractors)  
Topeka, Kansas 66620

1. Location of well: County <u>Ellis</u>		Xaction <u>NE 1/4 SE 1/4 NW 1/4</u>		Section number <u>28</u>	Township number <u>T 13 S R 18 E N</u>	Range number <u>18</u>
2. Distance and direction from nearest town or city: Street address of well location if in city: <u>2305 Canal Blvd</u>				3. Owner of well: <u>Leonard Dinges</u> R.R. or street: <u>2305 Canal</u> City, state, zip code: <u>Hays, Kansas 67601</u>		
X Locate with "X" in section below: N W E S 1 Mile		Sketch map: 		6. Bore hole dia. <u>9</u> in. Completion date <u>7/14/75</u> Well depth <u>61</u> ft.		
5. Type and color of material		From	To	7. <input type="checkbox"/> Cable tool <input checked="" type="checkbox"/> Rotary <input type="checkbox"/> Driven <input type="checkbox"/> Dug <input type="checkbox"/> Hollow rod <input type="checkbox"/> Jetted <input type="checkbox"/> Bored <input type="checkbox"/> Reverse rotary		
<u>Topsoil</u>		<u>0</u>	<u>3</u>	8. Use: <input type="checkbox"/> Domestic <input type="checkbox"/> Public supply <input type="checkbox"/> Industry <input type="checkbox"/> Irrigation <input type="checkbox"/> Air conditioning <input type="checkbox"/> Stock <input checked="" type="checkbox"/> Lawn <input type="checkbox"/> Oil field water <input type="checkbox"/> Other		
<u>Yellow Clay</u>		<u>3</u>	<u>12</u>	X Casing: Material <u>PVC</u> Height: <u>Above</u> or below Threading: <input type="checkbox"/> Welded <input checked="" type="checkbox"/> Surface <u>12</u> in. RMP: <input type="checkbox"/> PVC <input checked="" type="checkbox"/> Weight <u>28</u> lbs./ft. Dia. <u>5</u> in. to <u>61</u> ft. depth Wall Thickness: inches or Dia. <u>   </u> in. to <u>   </u> ft. depth Gauge No. <u>2258</u>		
<u>Brown Clay</u>		<u>12</u>	<u>40</u>	10. Screen: Manufacturer's name <u>Jet Stream</u> Type <u>slot</u> Dia. <u>5"</u> Slot/gauze <u>   </u> Length <u>10'</u> Set between <u>51</u> ft. and <u>61</u> ft. ft. and <u>   </u> ft.		
<u>Medium Sand</u>		<u>40</u>	<u>55</u>	Gravel pack? <u>Yes</u> Size range of material <u>1/4 - 1/2</u>		
<u>Gravel</u>		<u>55</u>	<u>59</u>	11. Static water level: <u>40</u> ft. below land surface Date <u>7-14-75</u> mo./day/yr.		
<u>Blue Shale</u>		<u>59</u>	<u>61</u>	12. Pumping level below land surfaces: <u>44</u> ft. after <u>1</u> hrs. pumping <u>10</u> g.p.m. <u>   </u> ft. after <u>   </u> hrs. pumping <u>   </u> g.p.m. Estimated maximum yield <u>10</u> g.p.m.		
				13. Water sample submitted: <u>   </u> mo./day/yr. <input type="checkbox"/> Yes <input checked="" type="checkbox"/> No Date <u>   </u>		
				14. Well head completion: <input type="checkbox"/> Pitless adapter <u>12</u> inches above grade		
				X Well grouted? <u>Yes</u> With: <input type="checkbox"/> Neat cement <input type="checkbox"/> Bentonite <input checked="" type="checkbox"/> Concrete Depth: From <u>1</u> ft. to <u>9</u> ft.		
				16. Nearest source of possible contamination: <u>None</u> ft. <u>   </u> Direction <u>   </u> Type <u>   </u> Well disinfected upon completion? <input checked="" type="checkbox"/> Yes <input type="checkbox"/> No		
				17. Pump: <u>   </u> Not installed Manufacturer's name <u>Red Jacket</u> Model number <u>BVC 501</u> HP <u>1/2</u> Volts <u>220</u> Length of drop pipe <u>55</u> ft. capacity <u>10</u> g.p.m. Type: <input checked="" type="checkbox"/> Submersible <input type="checkbox"/> Turbine <input type="checkbox"/> Jet <input type="checkbox"/> Reciprocating <input type="checkbox"/> Centrifugal <input type="checkbox"/> Other		
18. Elevation:		(Use a second sheet if needed)		X Water well contractor's certification: This well was drilled under my jurisdiction and this report is true to the best of my knowledge and belief. <u>Karst Water Well 199A</u> Business name <u>East Hwy 40 Hays</u> License No. <u>   </u> Address <u>   </u> Signed <u>Paul Karst</u> Date <u>7/14/75</u> Authorized representative		
19. Remarks: <u>None</u>						
Topography: <input checked="" type="checkbox"/> Hill <input checked="" type="checkbox"/> Slope <input type="checkbox"/> Upland <input type="checkbox"/> Valley						

Forward the white, blue and pink copies to the Department of Health and Environment

Form WWC-5