


1 LOCATION OF WATER WELL: County: ELLIS Fraction: SE 1/4 NW 1/4 SW 1/4 Section Number: 28 Township Number: T 13 S Range Number: R 18 E (W)

Distance and direction from nearest town or city street address of well if located within city?
503 W 30th St Hays Ks 67601

2 WATER WELL OWNER: John Hober
 RR#, St. Address, Box #: 503 W 30th St Board of Agriculture, Division of Water Resources
 City, State, ZIP Code: Hays Ks 67601 Application Number:

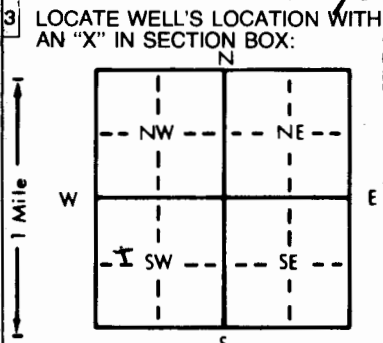

4 DEPTH OF COMPLETED WELL: 93 ft. ELEVATION:
 Depth(s) Groundwater Encountered 1. 63 ft. 2. ft. 3. ft.
 WELL'S STATIC WATER LEVEL: 63 ft. below land surface measured on mo/day/yr 3/5/84
 Pump test data: Well water was 30 ft. after 1 hours pumping 20 gpm
 Est. Yield 20 gpm: Well water was ft. after hours pumping gpm
 Bore Hole Diameter: 10 in. to ft., and in. to ft.
 WELL WATER TO BE USED AS:
 1 Domestic 3 Feedlot 6 Oil field water supply 9 Dewatering 12 Other (Specify below)
 2 Irrigation 4 Industrial 7 Lawn and garden only 10 Observation well
 Was a chemical/bacteriological sample submitted to Department? Yes No ; If yes, mo/day/yr sample was submitted
 Water Well Disinfected? Yes No

5 TYPE OF BLANK CASING USED:
 1 Steel 3 RMP (SR) 5 Wrought iron 8 Concrete tile CASING JOINTS: Glued Clamped
 PVC 4 ABS 6 Asbestos-Cement 9 Other (specify below) Welded
 Fiberglass Threaded
 Blank casing diameter: 7.5 in. to ft., Dia. in. to ft., Dia. in. to ft.
 Casing height above land surface: 20 in., weight lbs./ft. Wall thickness or gauge No. SDR 21
 TYPE OF SCREEN OR PERFORATION MATERIAL:
 PVC 10 Asbestos-cement
 1 Steel 3 Stainless steel 5 Fiberglass 8 RMP (SR) 11 Other (specify)
 2 Brass 4 Galvanized steel 6 Concrete tile 9 ABS 12 None used (open hole)
 SCREEN OR PERFORATION OPENINGS ARE:
 1 Continuous slot 3 Mill slot 5 Gauzed wrapped 8 Saw cut 11 None (open hole)
 2 Louvered shutter 4 Key punched 6 Wire wrapped 9 Drilled holes
 7 Torch cut 10 Other (specify)
 SCREEN-PERFORATED INTERVALS: From 63 ft. to 93 ft., From ft. to ft.
 GRAVEL PACK INTERVALS: From 45 ft. to 93 ft., From ft. to ft.

6 GROUT MATERIAL: 1 Neat cement 2 Cement grout 3 Bentonite 4 Other
 Grout Intervals: From 4 ft. to 14 ft., From ft. to ft., From ft. to ft.
 What is the nearest source of possible contamination:
 1 Septic tank 4 Lateral lines 7 Pit privy 11 Fuel storage 14 Abandoned water well
 2 Sewer lines 5 Cess pool 8 Sewage lagoon 12 Fertilizer storage 15 Oil well/Gas well
 3 Watertight sewer lines 6 Seepage pit 9 Feedyard 13 Insecticide storage 16 Other (specify below)
 Direction from well? West How many feet? 25

FROM	TO	LITHOLOGIC LOG	FROM	TO	LITHOLOGIC LOG
0	20	top soil			
20	63	brown clay			
63	90	Coarse to med Red & grey sand mixed with med to coarse white GRAVEL			
90	93	shale			

7 CONTRACTOR'S OR LANDOWNER'S CERTIFICATION: This water well was (1) constructed, (2) reconstructed, or (3) plugged under my jurisdiction and was completed on (mo/day/year) 3/8 and this record is true to the best of my knowledge and belief. Kansas Water Well Contractor's License No. 276. This Water Well Record was completed on (mo/day/yr) 3/12/84 under the business name of LUCA Water Well by (signature) John Luca

INSTRUCTIONS: Use typewriter or ball point pen, PLEASE PRESS FIRMLY and PRINT clearly. Please fill in blanks underline or circle the correct answers. Send top three copies to Kansas Department of Health and Environment, Division of Environment, Environmental Geology Section, Topeka, KS 66620. Send one to WATER WELL OWNER and retain one for your records.

OFFICE USE ONLY