


1 LOCATION OF WATER WELL: Fraction SW 1/4 NE 1/4 NE 1/4 Section Number 28 Township Number T 13 S Range Number R 18 EW
 County: Ellis

Distance and direction from nearest town or city street address of well if located within city?
In Hays

2 WATER WELL OWNER: Kevin Murphy
 RR#, St. Address, Box #: 3008 Northridge Ct. Board of Agriculture, Division of Water Resources
 City, State, ZIP Code: Hays, KS Application Number:

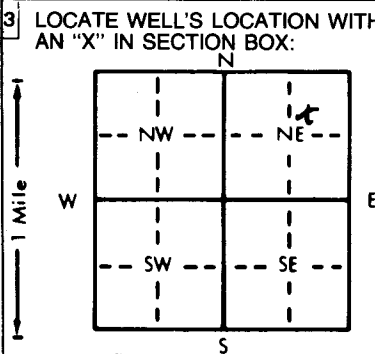

4 DEPTH OF COMPLETED WELL: 62 ft. ELEVATION:
 Depth(s) Groundwater Encountered 1. 45 ft. 2. ft. 3. ft.
 WELL'S STATIC WATER LEVEL 33 ft. below land surface measured on mo/day/yr 11/6/84
 Pump test data: Well water was ft. after hours pumping gpm
 Est. Yield 10 gpm; Well water was ft. after hours pumping gpm
 Bore Hole Diameter 9 3/4 in. to 62 ft., and in. to ft.
 WELL WATER TO BE USED AS:
 5 Public water supply 8 Air conditioning 11 Injection well
 1 Domestic 3 Feedlot 6 Oil field water supply 9 Dewatering 12 Other (Specify below)
 2 Irrigation 4 Industrial 7 Lawn and garden only 10 Observation well
 Was a chemical/bacteriological sample submitted to Department? Yes No; If yes, mo/day/yr sample was submitted
 Water Well Disinfected? Yes No

5 TYPE OF BLANK CASING USED:
 1 Steel 3 RMP (SR) 5 Wrought iron 8 Concrete tile CASING JOINTS: Glued X Clamped
2 PVC 4 ABS 6 Asbestos-Cement 9 Other (specify below) Welded
 7 Fiberglass Threaded
 Blank casing diameter 5.56 in. to 42 ft., Dia. in. to ft., Dia. in. to ft.
 Casing height above land surface 18 inches in., weight lbs./ft. Wall thickness or gauge No. SDR-26
 TYPE OF SCREEN OR PERFORATION MATERIAL:
 1 Steel 3 Stainless steel 5 Fiberglass 8 RMP (SR) 10 Asbestos-cement
 2 Brass 4 Galvanized steel 6 Concrete tile 9 ABS 11 Other (specify)
 12 None used (open hole)
 SCREEN OR PERFORATION OPENINGS ARE:
 1 Continuous slot 3 Mill slot 5 Gauzed wrapped 8 Saw cut 11 None (open hole)
 2 Louvered shutter 4 Key punched 6 Wire wrapped 9 Drilled holes
 7 Torch cut 10 Other (specify)
 SCREEN-PERFORATED INTERVALS: From 62 ft. to 42 ft., From ft. to ft.
 From ft. to ft., From ft. to ft.
 GRAVEL PACK INTERVALS: From 62 ft. to 35 ft., From ft. to ft.
 From ft. to ft., From ft. to ft.

6 GROUT MATERIAL: 1 Neat cement 2 Cement grout 3 Bentonite 4 Other
 Grout Intervals: From 10 ft. to 0 ft., From ft. to ft., From ft. to ft.
 What is the nearest source of possible contamination:
 1 Septic tank 4 Lateral lines 7 Pit privy 10 Livestock pens 14 Abandoned water well
 2 Sewer lines 5 Cess pool 8 Sewage lagoon 11 Fuel storage 15 Oil well/Gas well
3 Watertight sewer lines 6 Seepage pit 9 Feedyard 12 Fertilizer storage 16 Other (specify below)
 13 Insecticide storage
 Direction from well? South How many feet? 80 ft

FROM	TO	LITHOLOGIC LOG	FROM	TO	LITHOLOGIC LOG
0	6	Top soil			
6	13	yellow clay			
13	18	fine to medium sand w/ clay mix			
18	45	grey clay w/ limestone gravel			
45	51	fine to medium clay w/ grey clay			
		middle			
51	61	medium to coarse w/ clay bedding			
61	62	shale			

7 CONTRACTOR'S OR LANDOWNER'S CERTIFICATION: This water well was (1) constructed (2) reconstructed, or (3) plugged under my jurisdiction and was completed on (mo/day/year) 11/6/84 and this record is true to the best of my knowledge and belief. Kansas Water Well Contractor's License No. 455 This Water Well Record was completed on (mo/day/yr) 11/9/84 under the business name of Flour Power Supply by (signature) James L. Beck

INSTRUCTIONS: Use typewriter or ball point pen, PLEASE PRESS FIRMLY and PRINT clearly. Please fill in blanks, underline or circle the correct answers. Send top three copies to Kansas Department of Health and Environment, Division of Environment, Environmental Geology Section, Topeka, KS 66620. Send one to WATER WELL OWNER and retain one for your records.