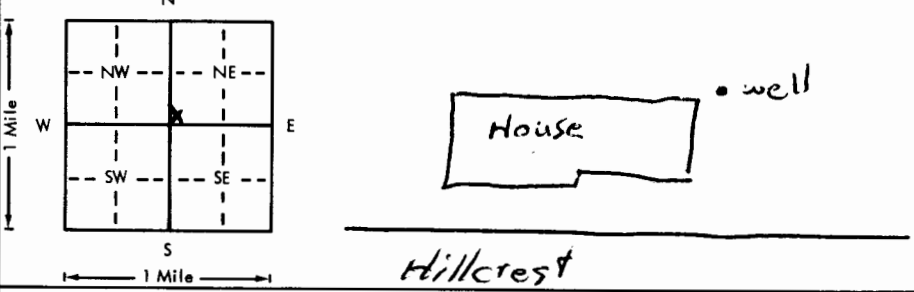


USE TYPEWRITER OR BALL POINT PEN—PRESS FIRMLY, PRINT CLEARLY.

WATER WELL RECORD
KSA 82a-1201-1215

Kansas Department of Health and Environment—Division of Environment
(Water well Contractors)
Topeka, Kansas 66620

1. Location of well:		County Ellis	Fraction SW 1/4 SW 1/4 NE 1/4	Section number 28	Township number T 13 S R 18 E (W)	Range number 18
2. Distance and direction from nearest town or city: Street address of well location if in city: 2921 Hillcrest Hays, Ks.				3. Owner of well: Donald Stout R.R. or street: SAME City, state, zip code:		
4. Locate with "X" in section below: N W E S 1 Mile Sketch map: 				6. Bore hole dia. 9 in. Completion date: 12-10-79 Well depth 70 ft.		
5. Type and color of material				7. <input type="checkbox"/> Cable tool <input checked="" type="checkbox"/> Rotary <input type="checkbox"/> Driven <input type="checkbox"/> Dug <input type="checkbox"/> Hollow rod <input type="checkbox"/> Jetted <input type="checkbox"/> Bored <input type="checkbox"/> Reverse rotary		
8. Use: <input type="checkbox"/> Domestic <input type="checkbox"/> Public supply <input type="checkbox"/> Industry <input checked="" type="checkbox"/> Irrigation <input type="checkbox"/> Air conditioning <input type="checkbox"/> Stock <input checked="" type="checkbox"/> Lawn <input type="checkbox"/> Oil field water <input type="checkbox"/> Other				9. Casing: Material pvc Height: Above or below Threaded <input type="checkbox"/> Welded <input checked="" type="checkbox"/> Surface 20 in. RMP 5 PVC <input checked="" type="checkbox"/> Weight 200 lbs./ft. Dia. 5 in. to 70 ft. depth Wall Thickness: inches or Dia. <input type="checkbox"/> in. to <input type="checkbox"/> ft. depth gage No. .26		
topsoil				10. Screens: Manufacturer's name Jet stream Type pvc Dia. 5 Slot/gage .031 Length 10 Set between 60 ft. and 70 ft. <input type="checkbox"/> ft. and <input type="checkbox"/> ft. Gravel pack? <input checked="" type="checkbox"/> Size range of material 1/2-1/4		
clay-gumbo				11. Static water level: 50 ft. below land surface Date 12-10-79 mg./day/yr.		
sand with clay				12. Pumping level below land surfaces: 60 ft. after 1 hrs. pumping 12 g.p.m. <input type="checkbox"/> ft. after <input type="checkbox"/> hrs. pumping <input type="checkbox"/> g.p.m. Estimated maximum yield 12 g.p.m.		
blue shale				13. Water sample submitted: <input type="checkbox"/> Yes <input checked="" type="checkbox"/> No Date		
				14. Well head completion: <input type="checkbox"/> Pitless adapter 20 Inches above grade		
				15. Well grouted? <input checked="" type="checkbox"/> With: <input checked="" type="checkbox"/> Neat cement <input type="checkbox"/> Bentonite <input type="checkbox"/> Concrete Depth: From 0 ft. to 10 ft.		
				16. Nearest source of possible contamination: none ft. <input type="checkbox"/> Direction <input type="checkbox"/> Type <input type="checkbox"/> Well disinfected upon completion? <input checked="" type="checkbox"/> Yes <input type="checkbox"/> No		
				17. Pump: <input checked="" type="checkbox"/> Not installed Manufacturer's name F&W Model number 5BA8 HP 1/2 Volts 220 Length of drop pipe 66 ft. capacity 10 g.p.m. Type: <input checked="" type="checkbox"/> Submersible <input type="checkbox"/> Turbine <input type="checkbox"/> Jet <input type="checkbox"/> Reciprocating <input type="checkbox"/> Centrifugal <input type="checkbox"/> Other		
(Use a second sheet if needed)				20. Water well contractor's certification: This well was drilled under my jurisdiction and this report is true to the best of my knowledge and belief. Karst Water Well 199 Business name East Hiway 40 Hays, Ks. License No. Address East Hiway 40 Hays, Ks. Signature [Signature] Date 12-10-79 Authorized representative		
18. Elevation:		19. Remarks:				
Topography: <input type="checkbox"/> Hill <input type="checkbox"/> Slope <input checked="" type="checkbox"/> Upland <input type="checkbox"/> Valley						

T 13 S R 18 E Sec 28 SUBSURVE 1/4 1/4 NW/4

Forward the white, blue and pink copies to the Department of Health and Environment

Form WWC-5