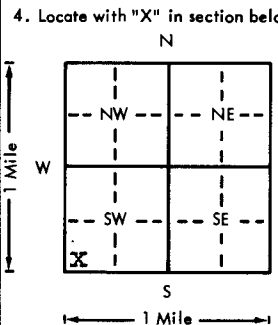
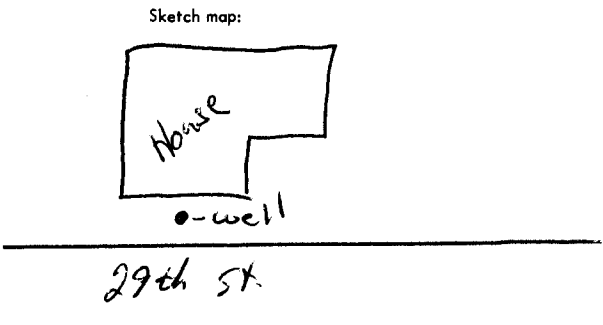


USE TYPEWRITER OR BALL POINT PEN-PRESS FIRMLY, PRINT CLEARLY.

WATER WELL RECORD
KSA 82a-1201-1215

Kansas Department of Health and Environment-Division of Environment
(Water well Contractors)
Topeka, Kansas 66620

1. Location of well:	County Ellis	Fraction SW 1/4 SW 1/4 SW 1/4	Section number 28	Township number T 13s S R 18W E/W	Range number
2. Distance and direction from nearest town or city: Street address of well location if in city: 2901 Walnut Hays, Ks			3. Owner of well: Terry Williamson R.R. or street: Same City, state, zip code:		
4. Locate with "X" in section below: 			Sketch map: 		
5. Type and color of material			From	To	6. Bore hole dia. 9 in. Completion date 8-15-79 Well depth 95 ft.
topsoil			0	5	7. <input checked="" type="checkbox"/> Cable tool <input checked="" type="checkbox"/> Rotary <input type="checkbox"/> Driven <input type="checkbox"/> Dug <input type="checkbox"/> Hollow rod <input type="checkbox"/> Jetted <input type="checkbox"/> Bored <input type="checkbox"/> Reverse rotary
gumbo clay			5	41	8. Use: <input type="checkbox"/> Domestic <input type="checkbox"/> Public supply <input type="checkbox"/> Industry <input checked="" type="checkbox"/> Irrigation <input type="checkbox"/> Air conditioning <input type="checkbox"/> Stock <input checked="" type="checkbox"/> Lawn <input type="checkbox"/> Oil field water <input type="checkbox"/> Other
sandy clay			41	65	9. Casing: Material pvc Height: Above or below Threaded <input type="checkbox"/> Welded <input checked="" type="checkbox"/> Surface 16 in. RMP <input type="checkbox"/> PVC <input checked="" type="checkbox"/> Weight 200 lbs./ft. Dia. 5 in. to 95 ft. depth Wall Thickness: inches or Dia. <input type="checkbox"/> in. to <input type="checkbox"/> ft. depth gage No. .26
coarse sand			65	90	10. Screen: Manufacturer's name jet stream Type pvc Dia. 5 Slot 3/32 .031 Length 20 Set between 75 ft. and 95 ft. <input type="checkbox"/> ft. and <input type="checkbox"/> ft. Gravel pack? <input checked="" type="checkbox"/> Size range of material 1/2 - 1/4
blue shale			90	95	11. Static water level: <input type="checkbox"/> mo./day/yr. 60 ft. below land surface Date 8-15-79
					12. Pumping level below land surfaces: 60 ft. after 1 hrs. pumping 20 g.p.m. <input type="checkbox"/> ft. after <input type="checkbox"/> hrs. pumping <input type="checkbox"/> g.p.m. Estimated maximum yield 20 g.p.m.
					13. Water sample submitted: <input type="checkbox"/> mo./day/yr. Yes <input checked="" type="checkbox"/> No Date
					14. Well head completion: <input type="checkbox"/> Pitless adapter 16 inches above grade
					15. Well grouted? <input checked="" type="checkbox"/> With: <input checked="" type="checkbox"/> Neat cement <input type="checkbox"/> Bentonite <input type="checkbox"/> Concrete Depth: From 1 ft. to 12 ft.
					16. Nearest source of possible contamination: none ft. <input type="checkbox"/> Direction <input type="checkbox"/> Type <input type="checkbox"/> Well disinfected upon completion? <input checked="" type="checkbox"/> Yes <input type="checkbox"/> No
					17. Pump: <input type="checkbox"/> Not installed Manufacturer's name F&W Model number 10BK9 HP 1 Volts 220 Length of drop pipe 87 ft. capacity 19 g.p.m. Type: <input checked="" type="checkbox"/> Submersible <input type="checkbox"/> Turbine <input type="checkbox"/> Jet <input type="checkbox"/> Reciprocating <input type="checkbox"/> Centrifugal <input type="checkbox"/> Other
18. Elevation:			19. Remarks:		
Topography: <input checked="" type="checkbox"/> Hill <input type="checkbox"/> Slope <input type="checkbox"/> Upland <input type="checkbox"/> Valley					
			20. Water well contractor's certification: This well was drilled under my jurisdiction and this report is true to the best of my knowledge and belief. Karst Water Well 199 Business name E. Hiway 40 Hays, Ks. License No. Address Phil Karst Date 8/1/80 Signed Phil Karst Authorized representative		

13 18 28 SWSWSW

Forward the white, blue and pink copies to the Department of Health and Environment

Form WWC-5