


1 LOCATION OF WATER WELL: County: Ellis Fraction: SW 1/4 NW 1/4 SE 1/4 Section Number: 28 Township Number: T 13 S Range Number: R 18 E/W

Distance and direction from nearest town or city street address of well if located within city?
In Hays

2 WATER WELL OWNER: Francis Kiebler
RR#, St. Address, Box #: 2927 Willow Board of Agriculture, Division of Water Resources
City, State, ZIP Code: Hays KS 67601 Application Number:

3 LOCATE WELL'S LOCATION WITH AN "X" IN SECTION BOX:

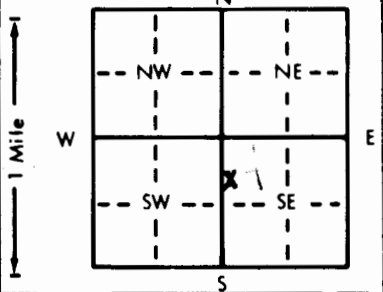

4 DEPTH OF COMPLETED WELL: 63 ft. ELEVATION:

Depth(s) Groundwater Encountered 1. 50 ft. 2. ft. 3. ft.

WELL'S STATIC WATER LEVEL: 46 ft. below land surface measured on mo/day/yr 4/2/86

Pump test data: Well water was ft. after hours pumping gpm

Est. Yield: 30+ gpm; Well water was ft. after hours pumping gpm

Bore Hole Diameter: 10 1/4 in. to 6 3/4 in. to in. to in. to ft.

WELL WATER TO BE USED AS:

5 Public water supply 8 Air conditioning 11 Injection well
1 Domestic 3 Feedlot 6 Oil field water supply 9 Dewatering 12 Other (Specify below)
2 Irrigation 4 Industrial 7 Lawn and garden only 10 Observation well

Was a chemical/bacteriological sample submitted to Department? Yes No X; If yes, mo/day/yr sample was submitted
Water Well Disinfected? Yes No

5 TYPE OF BLANK CASING USED:

1 Steel 3 RMP (SR) 5 Wrought iron 8 Concrete tile CASING JOINTS: Glued X Clamped
2 PVC 4 ABS 6 Asbestos-Cement 9 Other (specify below) Welded
7 Fiberglass Threaded

Blank casing diameter: 5.56 in. to 43 ft., Dia. in. to in. to in. to in. to ft.
Casing height above land surface: 14 inches in., weight lbs./ft. Wall thickness or gauge No. SDR-26

TYPE OF SCREEN OR PERFORATION MATERIAL:

1 Steel 3 Stainless steel 5 Fiberglass 8 RMP (SR) 11 Other (specify)
2 Brass 4 Galvanized steel 6 Concrete tile 9 ABS 12 None used (open hole)

SCREEN OR PERFORATION OPENINGS ARE:

1 Continuous slot 3 Mill slot 5 Gauzed wrapped 8 Saw cut 11 None (open hole)
2 Louvered shutter 4 Key punched 6 Wire wrapped 9 Drilled holes
7 Torch cut 10 Other (specify)

SCREEN-PERFORATED INTERVALS: From 63ft ft. to 43ft ft., From ft. to ft. to ft.

GRAVEL PACK INTERVALS: From 63ft ft. to 30ft ft., From ft. to ft. to ft.

6 GROUT MATERIAL: 1 Neat cement 2 Cement grout 3 Bentonite 4 Other

Grout intervals: From 10 ft. to 0 ft., From ft. to ft. to ft., From ft. to ft. to ft.

What is the nearest source of possible contamination:

1 Septic tank 4 Lateral lines 7 Pit privy 10 Livestock pens 14 Abandoned water well
2 Sewer lines 5 Cess pool 8 Sewage lagoon 11 Fuel storage 15 Oil well/Gas well
3 Watertight sewer lines 6 Seepage pit 9 Feedyard 12 Fertilizer storage 16 Other (specify below)
13 Insecticide storage

Direction from well? North How many feet? 20ft

FROM	TO	LITHOLOGIC LOG	FROM	TO	LITHOLOGIC LOG
0	9	Top soil			
9	38	Clay (yellow w/ some limestone gravel mixed in)			
38	50	yellow clay w/ fine sand mixed in			
50	62	medium to coarse sand with some limestone gravel			
62	63	Blue shale			

7 CONTRACTOR'S OR LANDOWNER'S CERTIFICATION: This water well was (1) constructed (2) reconstructed, or (3) plugged under my jurisdiction and was completed on (mo/day/year) 4/2/86 and this record is true to the best of my knowledge and belief. Kansas

Water Well Contractor's License No. 455 This Water Well Record was completed on (mo/day/yr) 4/26/86
under the business name of Kraus Pump & Supply by (signature) James Kiebler

INSTRUCTIONS: Use typewriter or ball point pen, PLEASE PRESS FIRMLY and PRINT clearly. Please fill in blank, underline or circle the correct answers. Send top three copies to Kansas Department of Health and Environment, Division of Environment, Environmental Geology Section, Topeka, KS 66620. Send one to WATER WELL OWNER and retain one for your records.