


1 LOCATION OF WATER WELL: County: ELLIS Fraction: NE 1/4 NE 1/4 SW 1/4 Section Number: 28 Township Number: T 13 S Range Number: R 18 EW

Distance and direction from nearest town or city street address of well if located within city?  
204 W 34 Hays KS 67601

2 WATER WELL OWNER: Rich Sook  
 RR#, St. Address, Box #: 204 W 34  
 City, State, ZIP Code: Hays KS 67601  
 Board of Agriculture, Division of Water Resources  
 Application Number:

3 LOCATE WELL'S LOCATION WITH AN "X" IN SECTION BOX:

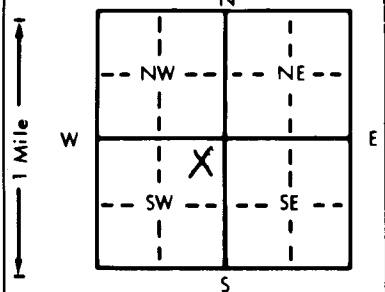

4 DEPTH OF COMPLETED WELL: 48 ft. ELEVATION:

Depth(s) Groundwater Encountered 1. 39 ft. 2. ft. 3. ft.  
 WELL'S STATIC WATER LEVEL 38 ft. below land surface measured on mo/day/yr 7/31/89  
 Pump test data: Well water was 9 ft. after 1 hours pumping 20 gpm  
 Est. Yield 20 gpm: Well water was ft. after hours pumping gpm  
 Bore Hole Diameter 1.0 in. to ft., and in. to ft.  
 WELL WATER TO BE USED AS:  
 1 Domestic     3 Feedlot     6 Oil field water supply     9 Dewatering     12 Other (Specify below)  
 2 Irrigation     4 Industrial     7 Lawn and garden only     10 Monitoring well  
 Was a chemical/bacteriological sample submitted to Department? Yes  No  If yes, mo/day/yr sample was submitted

5 TYPE OF BLANK CASING USED:  
 1 Steel     3 RMP (SR)  
 2 PVC     4 ABS  
 5 Wrought iron     8 Concrete tile    CASING JOINTS:  Glued     Clamped  
 6 Asbestos-Cement     9 Other (specify below)     Welded  
 7 Fiberglass     Threaded

Blank casing diameter 5 in. to ft., Dia. in. to ft., Dia. in. to ft.  
 Casing height above land surface 18 in., weight lbs./ft. Wall thickness or gauge No. SDR 26

TYPE OF SCREEN OR PERFORATION MATERIAL:  
 1 Steel     3 Stainless steel     5 Fiberglass     7 PVC     10 Asbestos-cement  
 2 Brass     4 Galvanized steel     6 Concrete tile     8 RMP (SR)     11 Other (specify)  
 12 None used (open hole)

SCREEN OR PERFORATION OPENINGS ARE:  
 1 Continuous slot     3 Mill slot     5 Gauzed wrapped     8 Saw cut     11 None (open hole)  
 2 Louvered shutter     4 Key punched     6 Wire wrapped     9 Drilled holes  
 7 Torch cut     10 Other (specify)

SCREEN-PERFORATED INTERVALS: From 28 ft. to 48 ft., From ft. to ft.  
 GRAVEL PACK INTERVALS: From 25 ft. to 48 ft., From ft. to ft.

6 GROUT MATERIAL:  1 Neat cement     2 Cement grout     3 Bentonite     4 Other  
 Grout Intervals: From 1 ft. to 21 ft., From ft. to ft., From ft. to ft.

What is the nearest source of possible contamination:  
 1 Septic tank     4 Lateral lines     7 Pit privy     10 Livestock pens     14 Abandoned water well  
 2 Sewer lines     5 Cess pool     8 Sewage lagoon     11 Fuel storage     15 Oil well/Gas well  
 3 Watertight sewer lines     6 Seepage pit     9 Feedyard     12 Fertilizer storage     16 Other (specify below)  
 13 Insecticide storage  
 Direction from well? EAST How many feet? 30

FROM	TO	LITHOLOGIC LOG	FROM	TO	PLUGGING INTERVALS
0	10	top soil			
10	38	brown clay			
38	46	med. to fine grey & red sand			
46	48	shale			

7 CONTRACTOR'S OR LANDOWNER'S CERTIFICATION: This water well was  (1) constructed,  (2) reconstructed, or  (3) plugged under my jurisdiction and was completed on (mo/day/year) 7/31/89 and this record is true to the best of my knowledge and belief. Kansas Water Well Contractor's License No. 276 This Water Well Record was completed on (mo/day/yr) 7/31/89 under the business name of HUEA Water Well Drilling by (signature) John Sook