


1 LOCATION OF WATER WELL: County: ELLIS Fraction: ~~NE~~ 1/4 SW 1/4 SW 1/4 Section Number: 28 Township Number: T 13 S Range Number: R 18 E

Distance and direction from nearest town or city street address of well if located within city?
513 W 31st Hays Ks

2 WATER WELL OWNER: ELI BOUCHER
RR#, St. Address, Box #: 513 W 31st Board of Agriculture, Division of Water Resources
City, State, ZIP Code: Hays Ks. 67601 Application Number:

3 LOCATE WELL'S LOCATION WITH AN "X" IN SECTION BOX:

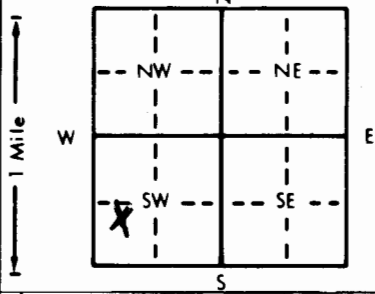

4 DEPTH OF COMPLETED WELL: 87' ft. ELEVATION:
Depth(s) Groundwater Encountered 1. 60 ft. 2. . ft. 3. . ft.
WELL'S STATIC WATER LEVEL: 60 ft. below land surface measured on mo/day/yr 10/10/89
Pump test data: Well water was 21 ft. after 1 hours pumping 20 gpm
Est. Yield 20 gpm: Well water was . ft. after . hours pumping . gpm
Bore Hole Diameter: 10 in. to . ft., and . in. to . ft.
WELL WATER TO BE USED AS:
 Domestic 3 Feedlot 6 Oil field water supply 9 Dewatering 12 Other (Specify below)
 2 Irrigation 4 Industrial 7 Lawn and garden only 10 Monitoring well
Was a chemical/bacteriological sample submitted to Department? Yes No If yes, mo/day/yr sample was submitted
Water Well Disinfected Yes No

5 TYPE OF BLANK CASING USED:
1 Steel 3 RMP (SR) 5 Wrought iron 8 Concrete tile CASING JOINTS: Glued Clamped
 2 PVC 4 ABS 6 Asbestos-Cement 9 Other (specify below) Welded .
Blank casing diameter 5 in. to . ft., Dia . in. to . ft., Dia . in. to . ft.
Casing height above land surface: 20 in., weight . lbs./ft. Wall thickness or gauge No. SDR 26
7 Fiberglass . Threaded.

TYPE OF SCREEN OR PERFORATION MATERIAL:
1 Steel 3 Stainless steel 5 Fiberglass 8 RMP (SR) 10 Asbestos-cement
2 Brass 4 Galvanized steel 6 Concrete tile 9 ABS 11 Other (specify) .
SCREEN OR PERFORATION OPENINGS ARE:
1 Continuous slot 8 Mill slot 5 Gauzed wrapped 8 Saw cut 11 None (open hole)
2 Louvered shutter 4 Key punched 6 Wire wrapped 9 Drilled holes
7 Torch cut 10 Other (specify) .

SCREEN-PERFORATED INTERVALS: From 60 ft. to 87 ft., From . ft. to . ft.
GRAVEL PACK INTERVALS: From 60 ft. to 87 ft., From . ft. to . ft.

6 GROUT MATERIAL: 1 Neat cement 2 Cement grout 3 Bentonite 4 Other .
Grout Intervals: From 2 ft. to 22 ft., From . ft. to . ft., From . ft. to . ft.
What is the nearest source of possible contamination:
1 Septic tank 4 Lateral lines 7 Pit privy 10 Livestock pens 14 Abandoned water well
2 Sewer lines 5 Cess pool 8 Sewage lagoon 11 Fuel storage 15 Oil well/Gas well
 3 Watertight sewer lines 6 Seepage pit 9 Feedyard 12 Fertilizer storage 16 Other (specify below)
13 Insecticide storage
Direction from well? West How many feet? 25

FROM	TO	LITHOLOGIC LOG	FROM	TO	PLUGGING INTERVALS
0	25	Top soil			
25	54	BROWN clay			
54	60	GREY clay			
60	84	layers of grey clay & fine to med grey sand			
84	87	shale			

7 CONTRACTOR'S OR LANDOWNER'S CERTIFICATION: This water well was constructed, reconstructed, or plugged under my jurisdiction and was completed on (mo/day/year) 10/10/89 and this record is true to the best of my knowledge and belief. Kansas Water Well Contractor's License No. 276 This Water Well Record was completed on (mo/day/yr) 10/10/89 under the business name of huer Water Well Drilling by (signature) John Jura