


1 LOCATION OF WATER WELL: County: **Ellis** Fraction: **NE 1/4 SE 1/4 NE 1/4** Section Number: **28** Township Number: **T 13 S** Range Number: **R 18 E W**

Distance and direction from nearest town or city street address of well if located within city? **Amoco #9667**  
**30' East north from center of front door of station, 3601 Vine, Hays, KS 52895060 MW-8**

2 WATER WELL OWNER: **Amoco Oil Company**  
 RR#, St. Address, Box #: **8700 Indian Creek Parkway, Bldg. 3, Ste. 180** Board of Agriculture, Division of Water Resources  
 City, State, ZIP Code: **Overland Park, KS 66210** Application Number:

3 LOCATE WELL'S LOCATION WITH AN "X" IN SECTION BOX:

4 DEPTH OF COMPLETED WELL: **30.0** ft. ELEVATION: **Approx. Surface Elev.: 2040**

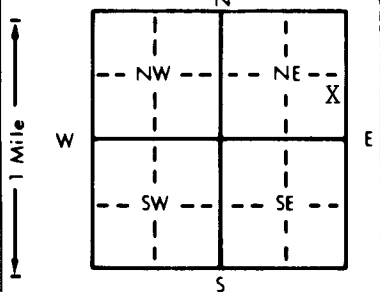

Depth(s) Groundwater Encountered 1. **21** ft. 2. ft. 3. ft.  
 WELL'S STATIC WATER LEVEL **22.1** ft. below land surface measured on mo/day/yr **12/26/89**  
 Pump test data: Well water was ft. after hours pumping gpm  
 Est. Yield **N/A** gpm: Well water was ft. after hours pumping gpm  
 Bore Hole Diameter **9** in. to **30.0** ft., and in. to ft.  
 WELL WATER TO BE USED AS:  
 5 Public water supply 8 Air conditioning 11 Injection well  
 1 Domestic 3 Feedlot 6 Oil field water supply 9 Dewatering 12 Other (Specify below)  
 2 Irrigation 4 Industrial 7 Lawn and garden only **10** Monitoring well  
 Was a chemical/bacteriological sample submitted to Department? Yes No **X**; If yes, mo/day/yr sample was submitted  
 Water Well Disinfected? Yes No **X**

5 TYPE OF BLANK CASING USED:  
 1 Steel 3 RMP (SR) 5 Wrought iron 8 Concrete tile CASING JOINTS: Glued Clamped  
**2** PVC 4 ABS 6 Asbestos-Cement 9 Other (specify below) Welded  
 7 Fiberglass Threaded **X**

Blank casing diameter **2** in. to **14.5** ft., Dia in. to ft., Dia in. to ft.  
 Casing height above land surface **-4** in., weight lbs./ft. Wall thickness or gauge No. **Schedule 40**

TYPE OF SCREEN OR PERFORATION MATERIAL:  
 1 Steel 3 Stainless steel 5 Fiberglass **7** PVC 10 Asbestos-cement  
 2 Brass 4 Galvanized steel 6 Concrete tile 8 RMP (SR) 11 Other (specify)  
 9 ABS 12 None used (open hole)

SCREEN OR PERFORATION OPENINGS ARE:  
 1 Continuous slot **3** Mill slot 5 Gauzed wrapped 8 Saw cut 11 None (open hole)  
 2 Louvered shutter 4 Key punched 6 Wire wrapped 9 Drilled holes  
 7 Torch cut 10 Other (specify)

SCREEN-PERFORATED INTERVALS: From **14.5** ft. to **29.5** ft., From ft. to ft.  
 From ft. to ft., From ft. to ft.  
 GRAVEL PACK INTERVALS: From **14.0** ft. to **30.0** ft., From ft. to ft.  
 From ft. to ft., From ft. to ft.

6 GROUT MATERIAL: 1 Neat cement **2** Cement grout **3** Bentonite 4 Other  
 Grout Intervals: From **0** ft. to **11.5** ft., From **11.5** ft. to **14.0** ft., From ft. to ft.

What is the nearest source of possible contamination:  
 1 Septic tank 4 Lateral lines 7 Pit privy **11** Fuel storage 14 Abandoned water well  
 2 Sewer lines 5 Cess pool 8 Sewage lagoon 12 Fertilizer storage 15 Oil well/Gas well  
 3 Watertight sewer lines 6 Seepage pit 9 Feedyard 13 Insecticide storage 16 Other (specify below)  
 Direction from well? **Northwest** How many feet? **10**

FROM	TO	LITHOLOGIC LOG	FROM	TO	PLUGGING INTERVALS
0	.2	Asphalt			
.2	1.0	Fill: Brown Fat Clay/Sand			
1.0	6.0	Gray-Brown Lean to Fat Clay			
6.0	17.5	Red-Brown Fat Clay			
17.5	21.0	Gray-Brown Lean to Fat Clay			
21.0	30.0	Light Red-Brown Fine Medium Clayey Sand			

7 CONTRACTOR'S OR LANDOWNER'S CERTIFICATION: This water well was **1** constructed, (2) reconstructed, or (3) plugged under my jurisdiction and was completed on (mo/day/year) **12/18/89** and this record is true to the best of my knowledge and belief. Kansas Water Well Contractor's License No. **416** This Water Well Record was completed on (mo/day/yr) **1/19/90** under the business name of **Terracon Consultants, Inc.** by (signature) *[Signature]*