


1 LOCATION OF WATER WELL: County: ELLIS Fraction: NC 1/4 NE 1/4 NW 1/4 Section Number: 28 Township Number: T 13 S Range Number: R 18 EW

Distance and direction from nearest town or city street address of well if located within city?

1002 W 38th St Hays Ks.

2 WATER WELL OWNER: Bob Weetenbarger Board of Agriculture, Division of Water Resources  
 RR#, St. Address, Box #: 1002 W 38th Application Number:  
 City, State, ZIP Code: Hays Ks 67601

3 LOCATE WELL'S LOCATION WITH AN "X" IN SECTION BOX:

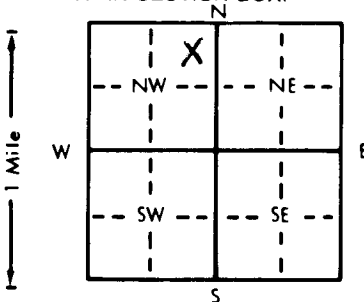

4 DEPTH OF COMPLETED WELL: 50 ft. ELEVATION:  
 Depth(s) Groundwater Encountered 1. 28 ft. 2. . . . . ft. 3. . . . . ft.  
 WELL'S STATIC WATER LEVEL 36 ft. below land surface measured on mo/day/yr 6/1/90  
 Pump test data: Well water was 2 ft. after 1 hours pumping 7 gpm  
 Est. Yield 7 gpm: Well water was . . . . . ft. after . . . . . hours pumping . . . . . gpm  
 Bore Hole Diameter 10 in. to . . . . . ft., and . . . . . in. to . . . . . ft.  
 WELL WATER TO BE USED AS: 5 Public water supply 8 Air conditioning 11 Injection well  
 ① Domestic 3 Feedlot 6 Oil field water supply 9 Dewatering 12 Other (Specify below)  
 2 Irrigation 4 Industrial 7 Lawn and garden only 10 Monitoring well  
 Was a chemical/bacteriological sample submitted to Department? Yes. . . . . No. ; If yes, mo/day/yr sample was submitted  
 Water Well Disinfected?  Yes No

5 TYPE OF BLANK CASING USED: 1 Steel 3 RMP (SR) 5 Wrought iron 8 Concrete tile CASING JOINTS: Stued Clamped  
 ② PVC 4 ABS 6 Asbestos-Cement 9 Other (specify below) Welded  
 7 Fiberglass Threaded

Blank casing diameter 5 in. to . . . . . ft., Dia . . . . . in. to . . . . . ft., Dia . . . . . in. to . . . . . ft.  
 Casing height above land surface 20 in., weight . . . . . lbs./ft. Wall thickness or gauge No. SDR: 20

TYPE OF SCREEN OR PERFORATION MATERIAL: 7 PVC 10 Asbestos-cement  
 1 Steel 3 Stainless steel 5 Fiberglass 8 RMP (SR) 11 Other (specify) . . . . .  
 2 Brass 4 Galvanized steel 6 Concrete tile 9 ABS 12 None used (open hole)

SCREEN OR PERFORATION OPENINGS ARE: 5 Gauzed wrapped 8 Saw cut 11 None (open hole)  
 1 Continuous slot ③ Mill slot 6 Wire wrapped 9 Drilled holes  
 2 Louvered shutter 4 Key punched 7 Torch cut 10 Other (specify) . . . . .

SCREEN-PERFORATED INTERVALS: From 30 ft. to 50 ft., From . . . . . ft. to . . . . . ft.  
 From . . . . . ft. to . . . . . ft., From . . . . . ft. to . . . . . ft.  
 GRAVEL PACK INTERVALS: From 25 ft. to 50 ft., From . . . . . ft. to . . . . . ft.  
 From . . . . . ft. to . . . . . ft., From . . . . . ft. to . . . . . ft.

6 GROUT MATERIAL: 1 Neat cement ② Cement grout 3 Bentonite 4 Other . . . . .  
 Grout Intervals: From 2 ft. to 22 ft., From . . . . . ft. to . . . . . ft., From . . . . . ft. to . . . . . ft.

What is the nearest source of possible contamination: 10 Livestock pens 14 Abandoned water well  
 1 Septic tank 4 Lateral lines 7 Pit privy 11 Fuel storage 15 Oil well/Gas well  
 2 Sewer lines 5 Cess pool 8 Sewage lagoon 12 Fertilizer storage 16 Other (specify below)  
 ③ Watertight sewer lines 6 Seepage pit 9 Feedyard 13 Insecticide storage

Direction from well? EAST How many feet? 25

FROM	TO	LITHOLOGIC LOG	FROM	TO	PLUGGING INTERVALS
0	5	top soil			
5	28	brown clay			
28	36	med to fine grey sand			
36	45	brown clay			
45	50	shale			

7 CONTRACTOR'S OR LANDOWNER'S CERTIFICATION: This water well was ① constructed, (2) reconstructed, or (3) plugged under my jurisdiction and was completed on (mo/day/year) 6/1/90 and this record is true to the best of my knowledge and belief. Kansas Water Well Contractor's License No. 276 This Water Well Record was completed on (mo/day/yr) 6/1/90 under the business name of Hues Water Well Drilling by (signature) John Hues