


1 LOCATION OF WATER WELL: Fraction SE 1/4 SE 1/4 NE 1/4 Section Number 28 Township Number T 13 S Range Number R 18 EW
 County: ELLIS

Distance and direction from nearest town or city street address of well if located within city?
AMOCO #9667 3601 VINE ST. APTS. KANSAS

2 WATER WELL OWNER: AMOCO OIL COMPANY
 RR#, St. Address, Box #: 8700 INDIAN CREEK PKWAY
 City, State, ZIP Code: OVERLAND PARK, KANSAS, 66210
 Board of Agriculture, Division of Water Resources
 Application Number: _____

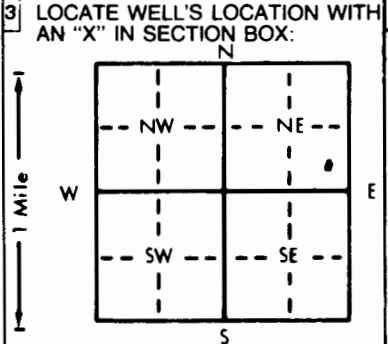

4 DEPTH OF COMPLETED WELL: 19.0 ft. ELEVATION: 101.17
 Depth(s) Groundwater Encountered 1. 2.5 ft. 2. _____ ft. 3. _____ ft.
 WELL'S STATIC WATER LEVEL 2.5 ft. below land surface measured on mo/day/yr 3-8-91
 Pump test data: Well water was NA ft. after _____ hours pumping _____ gpm
 Est. Yield _____ gpm/ Well water was _____ ft. after _____ hours pumping _____ gpm
 Bore Hole Diameter: 6/4 in. to 18.0 ft., and _____ in. to _____ ft.
 WELL WATER TO BE USED AS:
 5 Public water supply 8 Air conditioning 11 Injection well
 1 Domestic 3 Feedlot 6 Oil field water supply 9 Dewatering 12 Other (Specify below)
 2 Irrigation 4 Industrial 7 Lawn and garden only 10 Monitoring well _____
 Was a chemical/bacteriological sample submitted to Department? Yes No; If yes, mo/day/yr sample was submitted _____
 Water Well Disinfected? Yes No

5 TYPE OF BLANK CASING USED:
 1 Steel 3 RMP (SR) 5 Wrought iron 8 Concrete tile CASING JOINTS: Glued _____ Clamped _____
 2 Brass 4 ABS 6 Asbestos-Cement 9 Other (specify below) Welded _____
 7 Fiberglass _____ Threaded X
 Blank casing diameter _____ in. Dia _____ in. to _____ ft., Dia _____ in. to _____ ft.
 Casing height above land surface 0 in., weight _____ lbs./ft. Wall thickness or gauge No. #40
 TYPE OF SCREEN OR PERFORATION MATERIAL:
 1 Steel 3 Stainless steel 5 Fiberglass 8 RMP (SR) 10 Asbestos-cement
 2 Brass 4 Galvanized steel 6 Concrete tile 9 ABS 11 Other (specify) _____
 12 None used (open hole)
 SCREEN OR PERFORATION OPENINGS ARE:
 1 Continuous slot 3 Mill slot 5 Gauzed wrapped 8 Saw cut 11 None (open hole)
 2 Louvered shutter 4 Key punched 6 Wire wrapped 9 Drilled holes
 7 Torch cut 10 Other (specify) _____
 SCREEN-PERFORATED INTERVALS: From 18' ft. to 2' ft., From _____ ft. to _____ ft.
 From _____ ft. to _____ ft., From _____ ft. to _____ ft.
 GRAVEL PACK INTERVALS: From 18 ft. to 2' ft., From _____ ft. to _____ ft.
 From _____ ft. to _____ ft., From _____ ft. to _____ ft.

6 GROUT MATERIAL: 2 Neat cement 2 Cement grout 3 Bentonite 4 Other _____
 Grout Intervals: From 2 ft. to 1 ft., From 1 ft. to 1 ft., From _____ ft. to _____ ft.
 What is the nearest source of possible contamination:
 1 Septic tank 4 Lateral lines 7 Pit privy 10 Livestock pens 14 Abandoned water well
 2 Sewer lines 5 Cess pool 8 Sewage lagoon 11 Fuel storage 15 Oil well/Gas well
 3 Watertight sewer lines 6 Seepage pit 9 Feedyard 12 Fertilizer storage 16 Other (specify below)
FUEL TANKS

Direction from well? _____ How many feet? _____

FROM	TO	LITHOLOGIC LOG	FROM	TO	PLUGGING INTERVALS
0	4"	ASPHALT			
4"	3.5				
4"	3.5	SILTY CLAY, BROWN			
3.5	6.0	SILTY CLAY, GRAY			
6.0	8.5	SILTY CLAY, BROWN-GRAY			
8.5	13.5	CLAY, BROWN-GRAY			
13.5	16.5	CLAY, GRAY			
16.5	18.0	CLAY, GRAY			

7 CONTRACTOR'S OR LANDOWNER'S CERTIFICATION: This water well was (1) constructed, (2) reconstructed, or (3) plugged under my jurisdiction and was completed on (mo/day/year) 3-8-91 and this record is true to the best of my knowledge and belief. Kansas
 Water Well Contractor's License No. 579 This Water Well Record was completed on (mo/day/yr) 3-8-91
 under the business name of WEST NAZMAT DRILLING by (signature) Larry N. Jones