


1 LOCATION OF WATER WELL: County: ELLIS Fraction: NW 1/4 NW 1/4 Section Number: 28 Township Number: T 13 S Range Number: R 18 W E/W

Distance and direction from nearest town or city street address of well if located within city?

402 W 27th

2 WATER WELL OWNER: OLMER WHITMAN  
 RR#, St. Address, Box #: 402 W 27th  
 City, State, ZIP Code: HAYS KS 67601  
 Board of Agriculture, Division of Water Resources  
 Application Number:

3 LOCATE WELL'S LOCATION WITH AN "X" IN SECTION BOX:

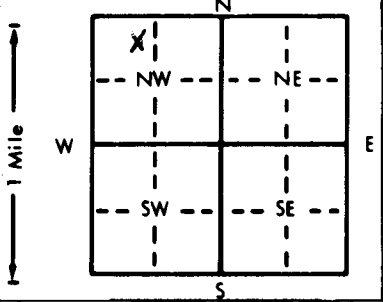

4 DEPTH OF COMPLETED WELL: 77' ft. ELEVATION: .....  
 Depth(s) Groundwater Encountered 1. 52' ft. 2. .... ft. 3. .... ft.  
 WELL'S STATIC WATER LEVEL 51' ft. below land surface measured on mo/day/yr .....  
 Pump test data: Well water was ..... ft. after ..... hours pumping ..... gpm  
 Est. Yield ..... gpm: Well water was ..... ft. after ..... hours pumping ..... gpm  
 Bore Hole Diameter: 10 in. to 7.75 in. and ..... in. to ..... in.  
 WELL WATER TO BE USED AS:  
 1 Domestic 3 Feedlot 6 Oil field water supply 9 Dewatering 12 Other (Specify below)  
 2 Irrigation 4 Industrial 7 Lawn and garden only 10 Observation well  
 Was a chemical/bacteriological sample submitted to Department? Yes ..... No ; If yes, mo/day/yr sample was submitted  
 Water Well Disinfected? Yes  No

5 TYPE OF BLANK CASING USED:  
 1 Steel 3 RMP (SR) 5 Wrought iron 8 Concrete tile CASING JOINTS: Glued Clamped .....  
2 PVC 4 ABS 6 Asbestos-Cement 9 Other (specify below) Welded .....  
 7 Fiberglass Threaded .....  
 Blank casing diameter 8.5 in. to 37 ft., Dia ..... in. to ..... ft., Dia ..... in. to ..... ft.  
 Casing height above land surface 12 in., weight 160 lbs./ft. Wall thickness or gauge No. SDR 26

TYPE OF SCREEN OR PERFORATION MATERIAL:  
 1 Steel 3 Stainless steel 5 Fiberglass 8 RMP (SR) 10 Asbestos-cement 11 Other (specify) .....  
 2 Brass 4 Galvanized steel 6 Concrete tile 9 ABS 12 None used (open hole)

SCREEN OR PERFORATION OPENINGS ARE:  
 1 Continuous slot 3 Mill slot 5 Gauzed wrapped 8 Saw cut 11 None (open hole)  
 2 Louvered shutter 4 Key punched 6 Wire wrapped 9 Drilled holes  
 7 Torch cut 10 Other (specify) .....

SCREEN-PERFORATED INTERVALS: From 5.7 ft. to 7.7 ft., From ..... ft. to ..... ft.  
 From ..... ft. to ..... ft., From ..... ft. to ..... ft.  
 GRAVEL PACK INTERVALS: From 7.7 ft. to 40 ft., From ..... ft. to ..... ft.  
 From ..... ft. to ..... ft., From ..... ft. to ..... ft.

6 GROUT MATERIAL: 1 Neat cement 2 Cement grout 3 Bentonite 4 Other .....  
 Grout Intervals: From 4 ft. to 30 ft., From ..... ft. to ..... ft., From ..... ft. to ..... ft.  
 What is the nearest source of possible contamination:  
 1 Septic tank 4 Lateral lines 7 Pit privy 10 Livestock pens 14 Abandoned water well  
 2 Sewer lines 5 Cess pool 8 Sewage lagoon 11 Fuel storage 15 Oil well/Gas well  
3 Watertight sewer lines 6 Seepage pit 9 Feedyard 12 Fertilizer storage 16 Other (specify below)  
 13 Insecticide storage

Direction from well? How many feet?

| FROM | TO | LITHOLOGIC LOG            | FROM | TO | LITHOLOGIC LOG |
|------|----|---------------------------|------|----|----------------|
| 0    | 2  | TOP SOIL                  |      |    |                |
| 2    | 15 | YELLOW CLAY               |      |    |                |
| 15   | 33 | YELLOW CLAY / W FINE SAND |      |    |                |
| 33   | 40 | GRAY CLAY                 |      |    |                |
| 40   | 60 | CLAY MIXED W/ FINE SAND   |      |    |                |
| 60   | 75 | MEDIUM COARSE SAND        |      |    |                |
| 75   | 77 | SHALE                     |      |    |                |

7 CONTRACTOR'S OR LANDOWNER'S CERTIFICATION: This water well was (1) constructed, (2) reconstructed, or (3) plugged under my jurisdiction and was completed on (mo/day/year) 8/3/90 and this record is true to the best of my knowledge and belief. Kansas Water Well Contractor's License No. 478. This Water Well Record was completed on (mo/day/yr) 8/13/90 under the business name of Spanner's Well Waterwell by (signature) [Signature]

INSTRUCTIONS: Use typewriter or ball point pen. PLEASE PRESS FIRMLY and PRINT clearly. Please fill in blanks, underline or circle the correct answers. Send top three copies to Kansas Department of Health and Environment, Office of Oil Field and Environmental Geology, Regulation and Permitting Section, Topeka, Kansas 66620-7500, Telephone: 913-862-9360. Send one to WATER WELL OWNER and retain one for your records.